


.180" supplied by STAR group
~~.198 (5mm) 2 of Cu~~
 .178 (4.5mm) 2oz COPPER 1 SIDE
 (change per John Boehm 2/24/95)

a900w1
 24A 4541

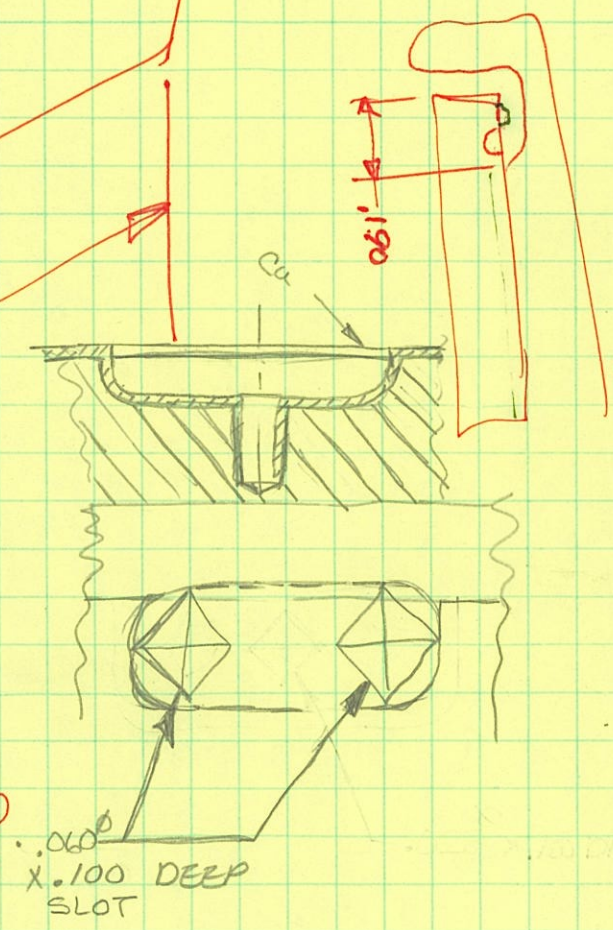

.060
 X .100 DEEP
 SLOT

***** LBL BOARD A000900U1 *****
***** MARCH 21, 1995 *****
***** WHEEL W900INFO *****

NEED 1 STANDARD PHOTO PLOT, 1 POSITIVE AND 1 NEGATIVE.
FILM SIZE IS APPROXIMATELY 28.500 X 1.50 12.400 INCHES.
DELIVERY DATE: MARCH 24, 1995 OR SOONER.

PHOTO PLOT FILES IN POSITIVE FORMAT:

PL900U1 - SINGLE SIDED BOARD

PLEASE MAKE CONTACT COPIES OF PLOT FILE (1). I NEED ONE (1) POSITIVE
AND ONE (1) NEGATIVE, EMULSION DOWN, RIGHT READING.

IF THERE ARE ANY QUESTIONS OR PROBLEMS PLEASE CALL -JUDY- (916)
547-4005.

tr10 10 circle trace 10;
tr12 11 circle trace 12;
tr15 12 circle trace 15;
tr20 13 circle trace 20;
tr30 14 circle trace 30;
tr40 15 circle trace 40;
tr50 16 circle trace 50;
tr60 17 circle trace 60;
tr70 18 circle trace 70;
tr80 19 circle trace 80;
tr90 70 circle trace 90;
tr100 71 circle trace 100;
tr120 20 circle trace 120;
tr130 21 circle trace 130;
tr150 22 circle trace 150;
f140 23 circle flash 40;
f150 24 circle flash 50;
f160 25 circle flash 60;
f170 26 circle flash 70;
f175 27 circle flash 75;
f185 28 circle flash 85;
f190 29 circle flash 90;
f1100 72 circle flash 100;
f1110 73 circle flash 110;
f1120 30 circle flash 120;
f1130 31 circle flash 130;
f1140 32 circle flash 140;
f1150 33 circle flash 150;
f1160 34 circle flash 160;
f1200 35 circle flash 200;
PADEX0 36 rectangle flash 80 55;
PADEX0 37 rectangle flash 55 80;
PADEXR 38 rectangle flash 75 55;
PADEXR 39 rectangle flash 55 75;
ftarget 40 square special 1.0;
fs60 41 square flash 60;
fs70 42 square flash 70;
fs75 43 square flash 75;
fs85 44 square flash 85;
fs100 45 square flash 100;
fs110 46 square flash 110;
fs120 47 square flash 120;
fs130 48 square flash 130;
fs140 49 square flash 140;
fs150 50 square flash 150;

PARTS LIST

TITLE: STAR TPC
 TEST ELECTRONICS
 SAS-16, AUTOTESTER DUT BOARD

FILE NO.: a000899c1 REV:
 PRINT NO.: 24A4531 C-1
 CHANGES (*):

ENGINEER: CHINH VU
 DRAFTER: STIRKKINEN

DATE: 03/13/95
 PAGE: 3 OF 6

Reference	Stock No.	Part Type	Description
		** RESISTORS **	
R1,R2,R3,R4,R5,R6, R7,R8,R9,R10,R11, R12,R13,R14,R15, R16		R510_JEZC	510,SMD
R17,R22		R4^3KJEZC	4.3K,SMD
R18,R23		R2^2KJEZC	2.2K,SMD
R19,R20,R24,R25, R76,R92,R95,R96, R97,R98,R99,R100, R101,R102,R103,R104, R105,R106,R107,R108, R109,R110,R111		R1^0KJEZC	1K,SMD
R21,R26		R82KJJCA	82,2W,CC
R27,R33,R39,R45, R78,R80,R82		R1-0JEZC R10_JEZC	1,1%,1/8W,M.F. 10,SMD
R28,R34,R40,R46, R94		RV10KKGET5	10K,1/2W
R29,R35,R41,R47		R46^4KFEZC	46.4K,1%,SMD
R30,R32,R36,R38, R42,R44,R48,R50		R511KFEZC	511K,1%,SMD
R31,R37,R43,R49		R51^1KFEZC	51.1K,1%,SMD
R51,R52,R53,R54, R64,R65		R10^0KFEZC	10.00K,1%,SMD
R55,R83,R84,R85, R86,R87,R88,R89, R90		R10KJEZC	10K,SMD,SIZE 1206
R56		R75KJEZC	75K,SMD
R57,R58		R56KJEZC	56K,SMD
R59,R60,R61,R62, R66,R67		R10^0KJEZC	10K,SMD
R63		R100KJEZC	100K,SMD

28240
-18950

9290
-200

9090
-50
9040

-7950
260
8210

-8000
260
8260

4645
9290

~~20040~~

28,100
20,040
8,060
200
8,260

ADDED MATERIAL

2660
2
1320

8010
~~20700~~
28100

20090
50
20040
11
9090

9240
19000
28240

BOTTOM .230

TOP .230



28040
60
28100

~~9090~~
9090
1030
8010

-28240




8260

-19000

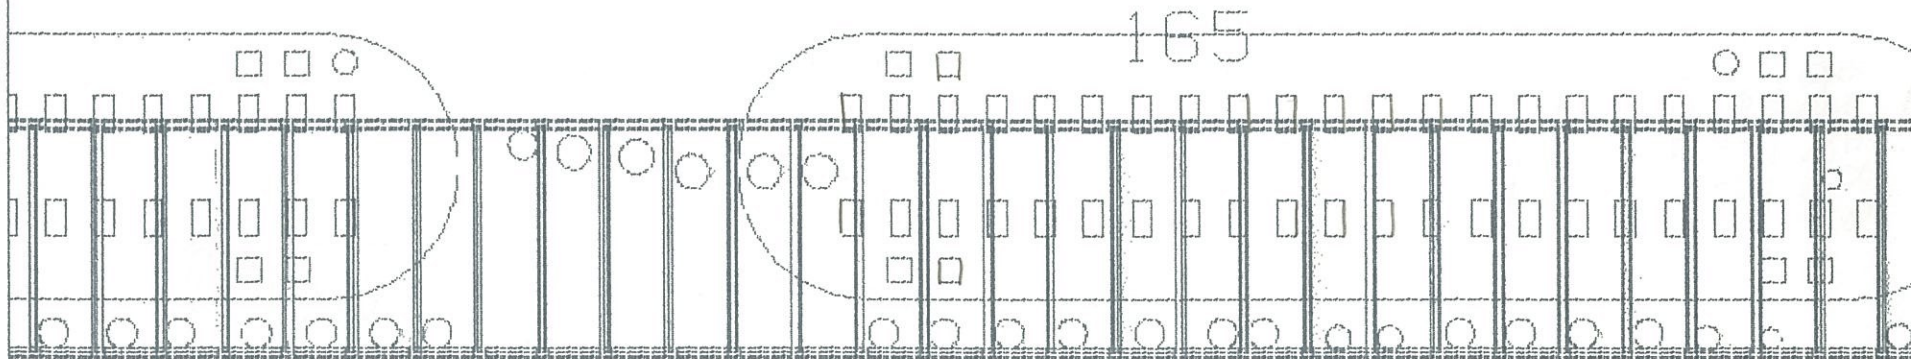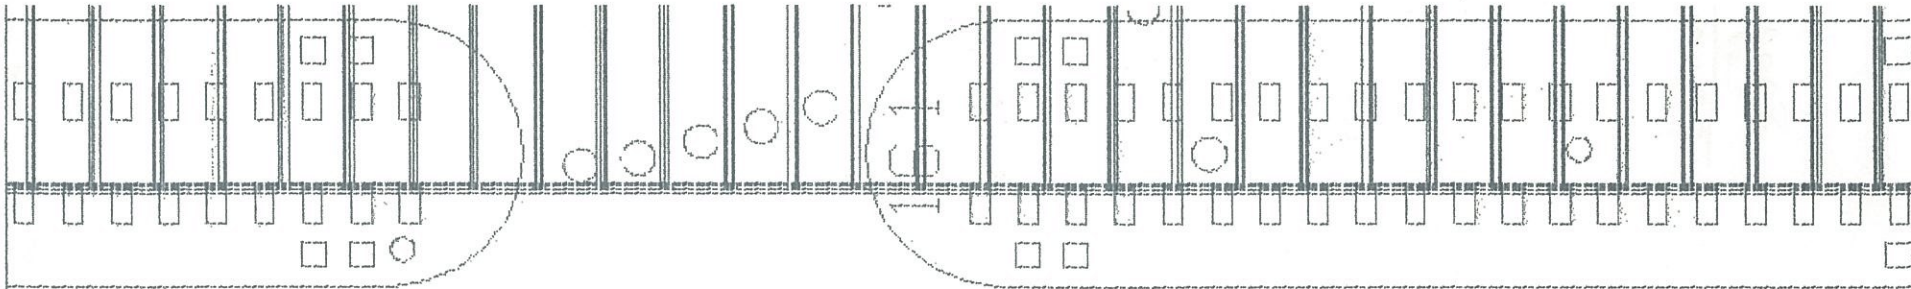

G:5.0 2 :X3.27 :GRID

REQ	ITEM	PART NUMBER	DESCRIPTION
		24A3993	INNER SHIELD GRID WIRE MOUNT EXTRUSION

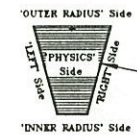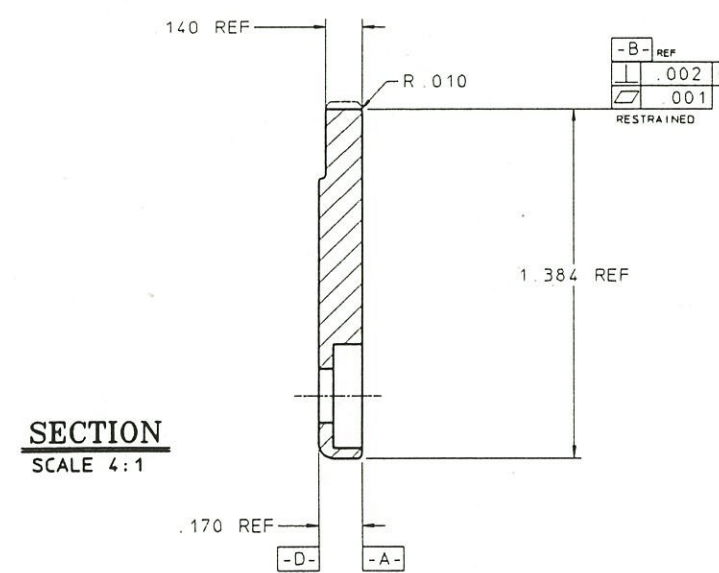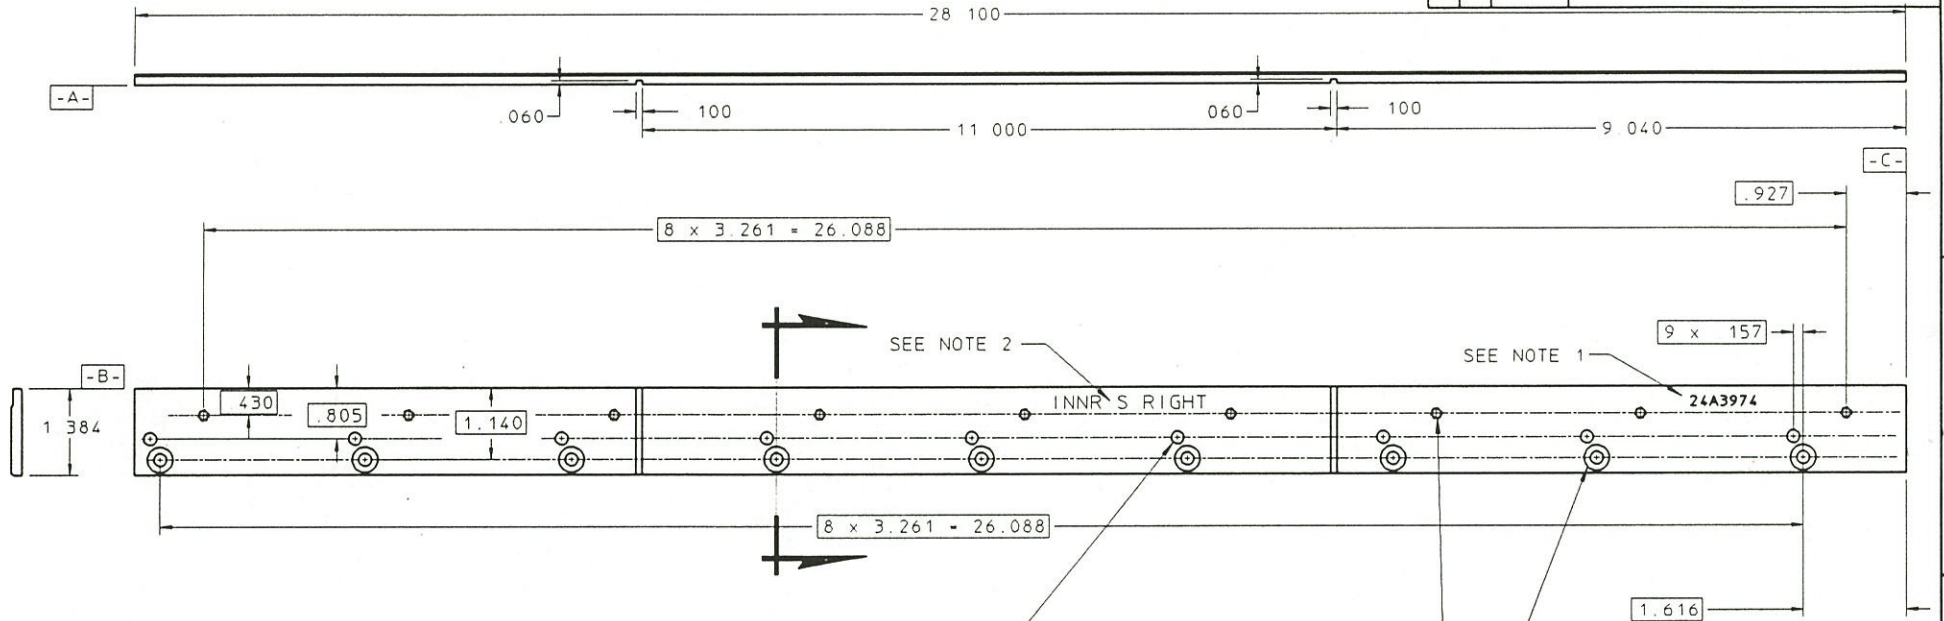


LOCATION of THIS PART in ASSEMBLY

NOTES

1. VIBRA-ETCH or ENGRAVE PART No 24A3974 IN 15 HIGH CHARACTERS IN LOCATION SHOWN.
2. VIBRA ETCH or ENGRAVE 'INNER S RIGHT' IN .2 CHARACTERS IN LOCATION SHOWN.


UNLESS OTHERWISE SPECIFIED		SHOP ORDERS		LAWRENCE BERKELEY LABORATORY				
CLASS	FRAC.	ACC.	TEST	UNIVERSITY OF CALIFORNIA-BERKELEY				
XX	± 1	1/64	NO	RHIC-STAR-TPC				
XX	± 02	1°	NO	INNER SECTOR				
XX	± 005	125.7	NO	SHIELD WIRE MOUNT RIGHT				
THREADS ARE CLASS 2		SHARP FILE CLEAR AND OILZE 0002/ 8003		PATENT CLEAR				
CHAMFER ENDS OF ALL SCREW THREADS BY CH 1.5 PITCH AND RELIEF WITH ROUND END FOR ON MACHINE CUT THREADS		SEE NOTES		DWG TYPE				
BREAK SIDES .124 DIA ON MACHINED WORK REMOVE BURRS WELD SPLATTER & LOOSE SCALE		DATE 12.01.14		SCALE FULL				
REFERENCES: AMS1 Y14.5 & B44.1		DATE 12.01.14		Dwg No				
		CHK J. BERCOVITZ		CATEGORY				
				24A3974				
REV	DWG	CHK	ZONE	DATE	CHANGES			

SECTION SCALE 4:1

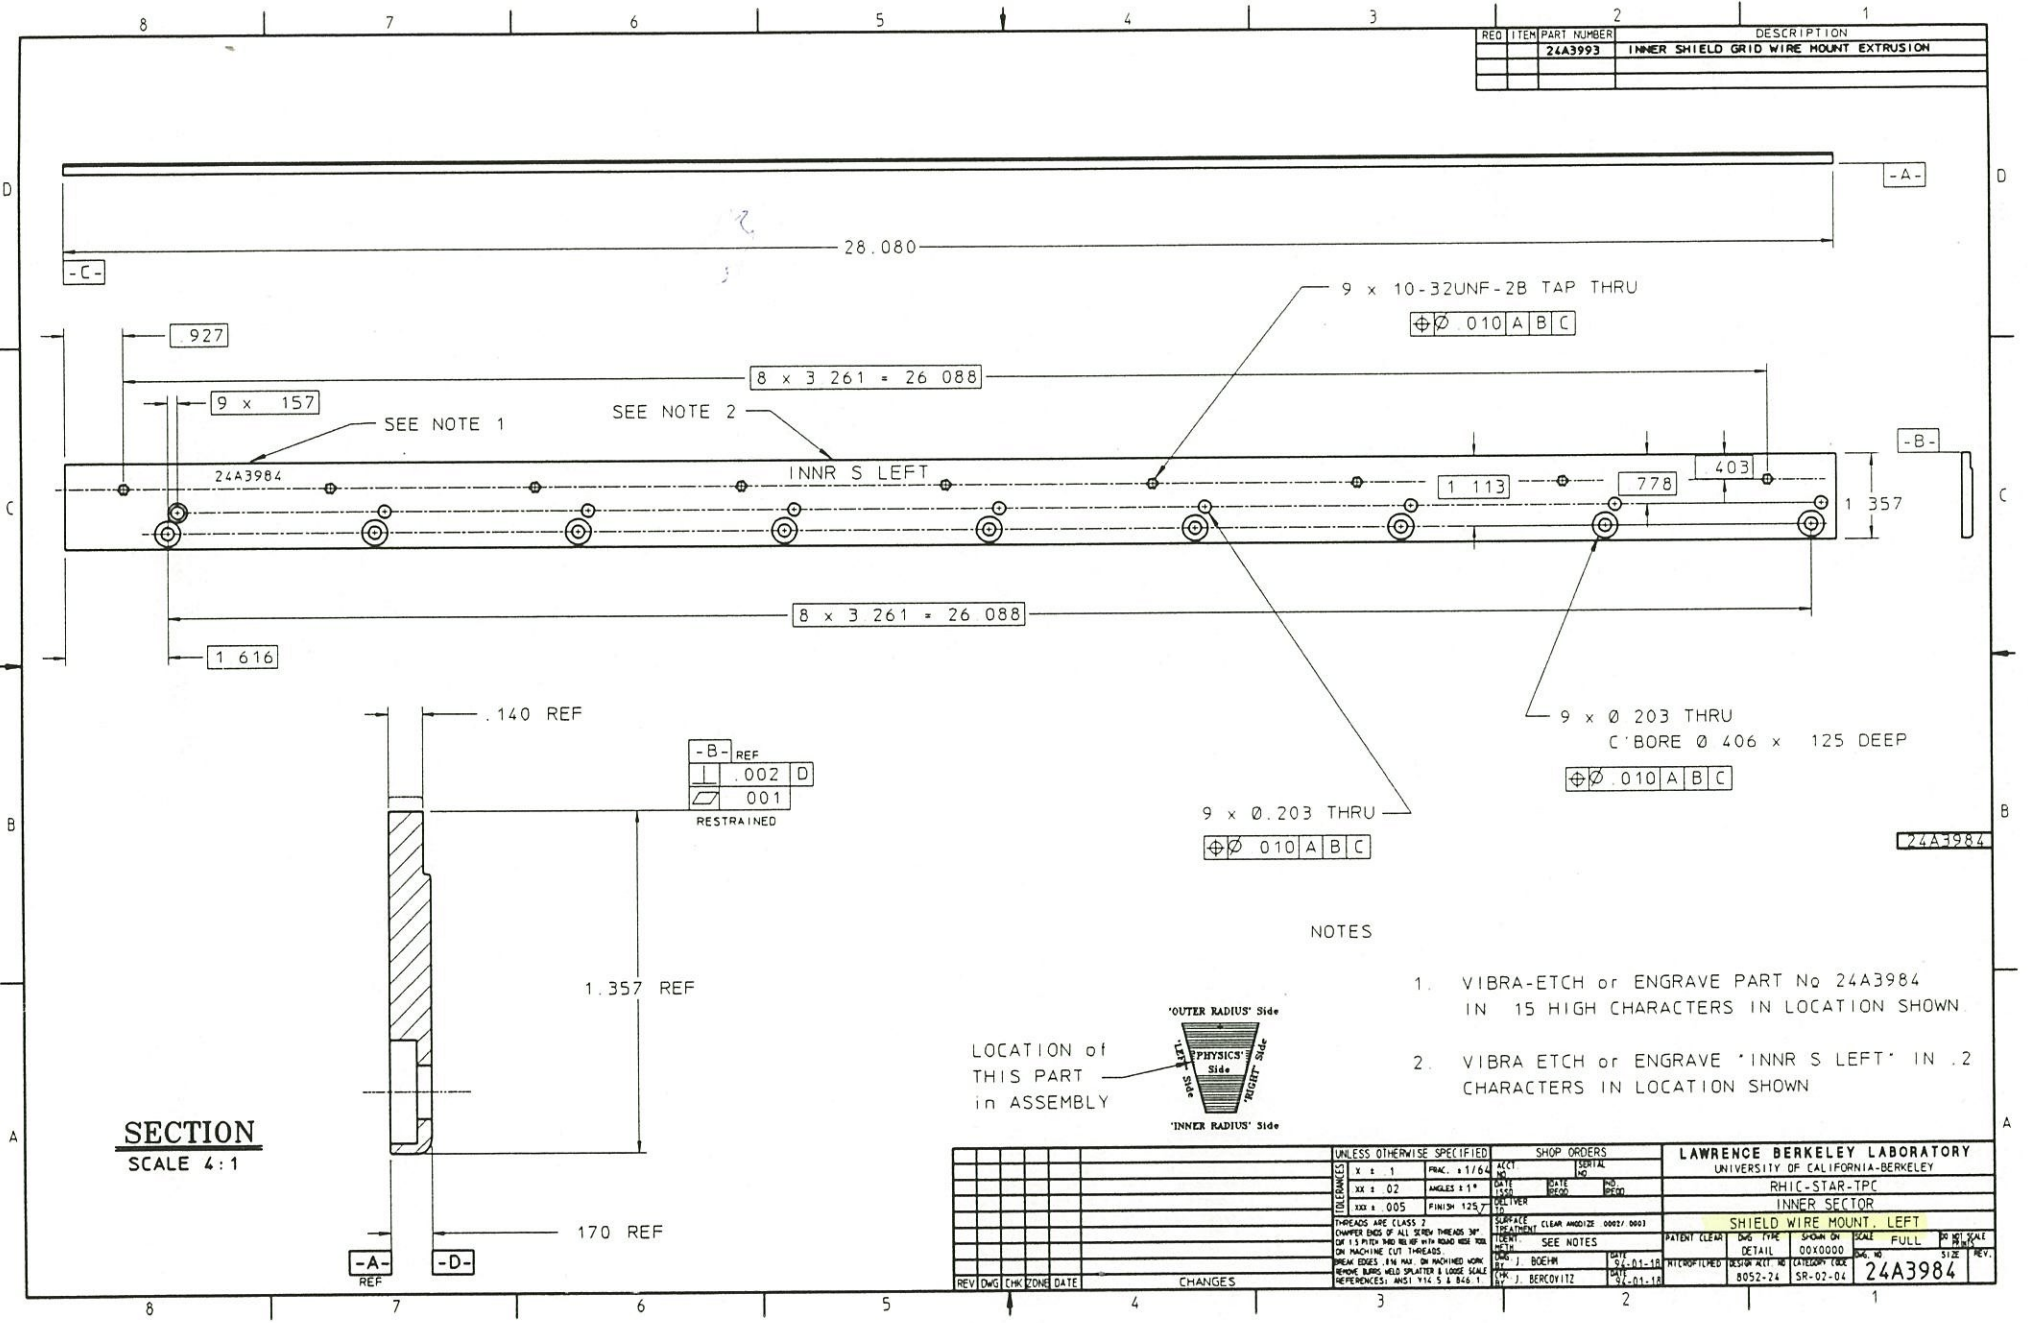

REQ	ITEM	PART NUMBER	DESCRIPTION
		24A3993	INNER SHIELD GRID WIRE MOUNT EXTRUSION


SECTION
SCALE 4:1

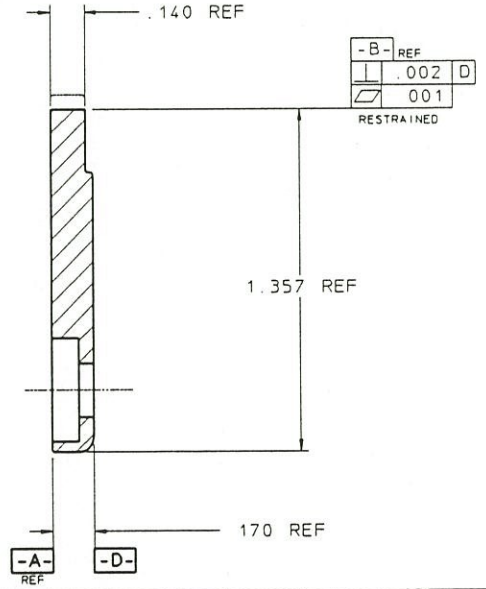

-B-	REF	D
	0.002	
/	0.01	
RESTRAINED		

NOTES




- VIBRA-ETCH or ENGRAVE PART No 24A3984 IN 15 HIGH CHARACTERS IN LOCATION SHOWN
- VIBRA ETCH or ENGRAVE 'INNER S LEFT' IN .2 CHARACTERS IN LOCATION SHOWN

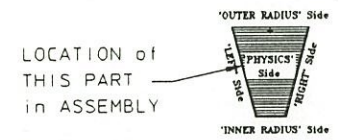

REV	CHK'D	DATE	CHANGES

UNLESS OTHERWISE SPECIFIED		SHOP ORDERS		LAWRENCE BERKELEY LABORATORY			
CO	X ± 1	FRAC.	+ 1/64	ACT	SERIAL	UNIVERSITY OF CALIFORNIA-BERKELEY	
ANGLE	XX ± 02	ANGLES	± 1°	DATE	DATE	RHIC-STAR-TPC	
FIN	± 0.05	FINISH	125, 7	DELIVER		INNER SECTOR	
THREDS	2-CLASS 2	SCAFF	TREATMENT	CLEAR	AM/IZE	SHIELD WIRE MOUNT, LEFT	
CHAMFER ENDS OF ALL SCREW THREADS 30°				SEE NOTES		PATENT CLEAR	
OF 1.5 PITCH AND RELIEF WITH ROUND END TOOL				ON MACHINING CUT THREADS		DRAWN BY	
REMOVE BURRS W/50 SPRAYER & LOOSE SCALE				REFERENCES: AWSI 114.5 & 846.1		FULL	
BOEHN		BOENH		SR-02-04		24A3984	
BERCOVITZ		BERCOVITZ		SR-02-04		24A3984	

REQ	ITEM	PART NUMBER	DESCRIPTION
			ALUMINUM 6063-T5

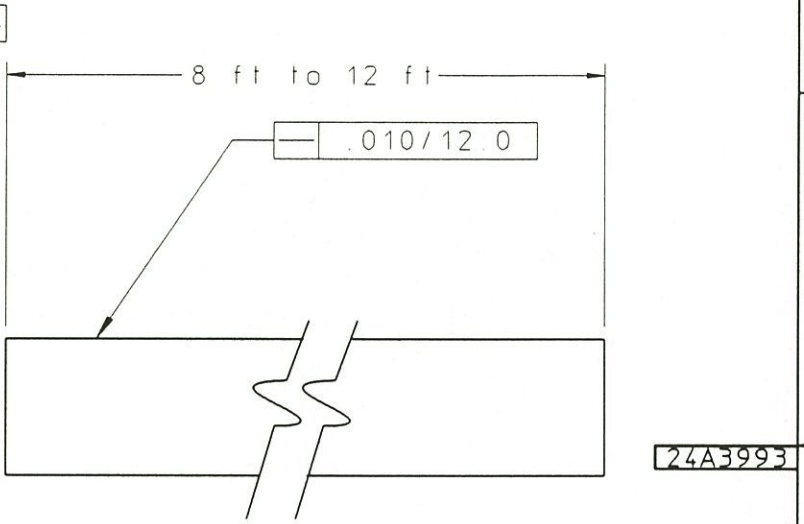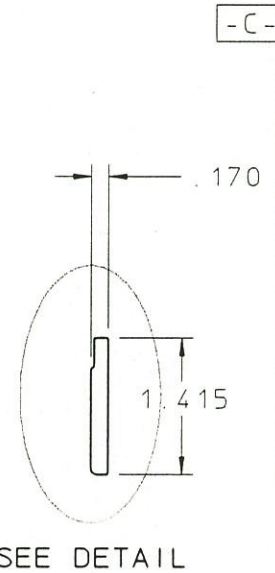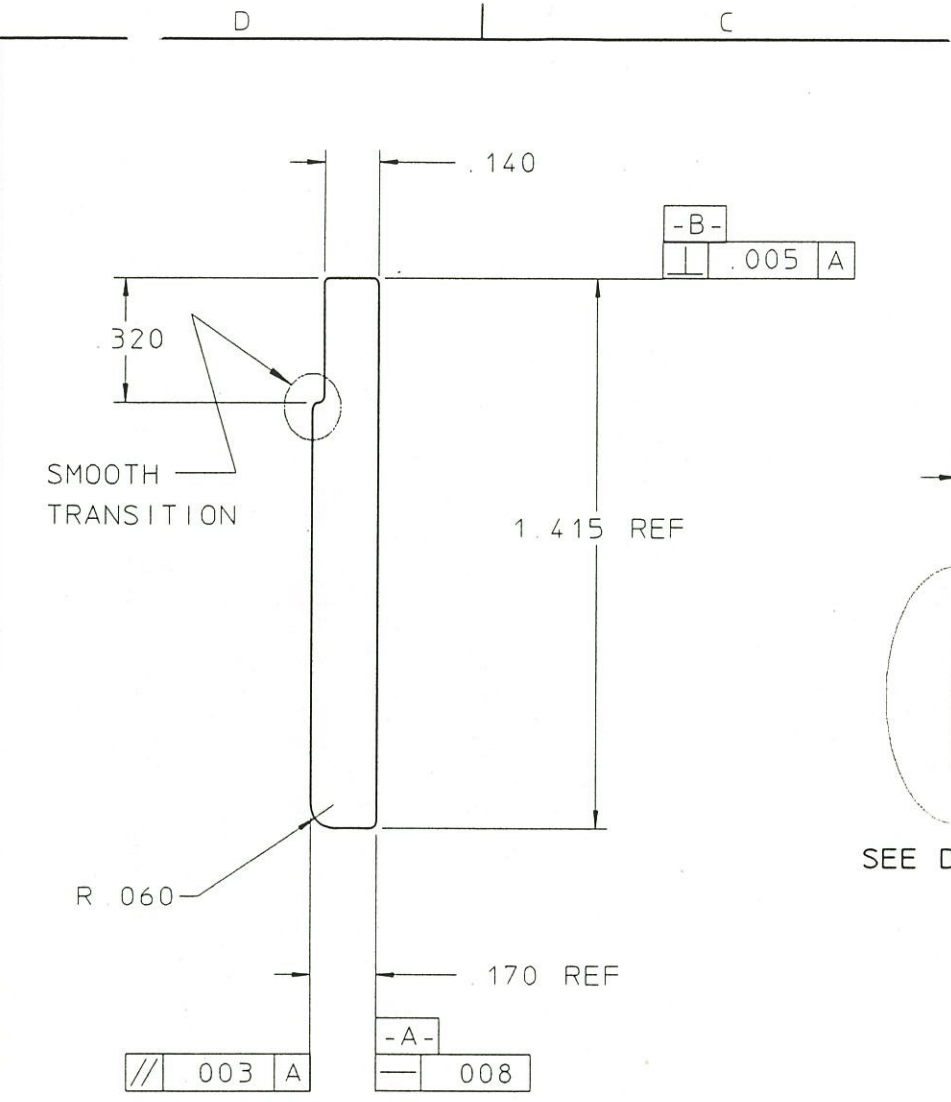


- NOTE
1. ALL RADII .015" UNLESS OTHERWISE NOTED
 2. WEIGHT .270 lbs/ft
 3. TWIST NOT TO EXCEED .010/12

DETAIL
SCALE 4:1


UNLESS OTHERWISE SPECIFIED				SHOP ORDERS				LAWRENCE BERKELEY LABORATORY					
TOLERANCES	x ± .1	FRAC ± 1/64	ACCT NO.	SERIAL NO.	UNIVERSITY OF CALIFORNIA-BERKELEY								
	.XX ± .02	ANGLES ± .01°	DATE ISSD	DATE RECD	RHIC STAR TPC								
	.XXX ± .005	FINISH 125	DELIVER TO	NO RECD	INNER SECTOR ASSEMBLY								
	THREADS ARE CLASS 2			SURFACE TREATMENT DEGREASE				SHIELD GRID WIRE MOUNT EXTRUSION					
	CHAMFER ENDS OF ALL SCREW THREADS 30°			IDENT METH TAG				PATENT CLEAR	DWG TYPE	SHOWN ON	SCALE	FULL	DO NOT SCALE PRINTS
	CUT 1.5 PITCH THIRD RELIEF WITH ROUND NOSE TOOL ON MACHINE CUT THREADS			DWG BY J BOEHM				DATE 94-01-18	DETAIL	00X0000	SCALE	FULL	DO NOT SCALE PRINTS
	BREAK EDGES .016 MAX. ON MACHINED WORK			CHK BY J BERCOVITZ				DATE 97-11-05	DESIGN ACCT NO	CATEGORY CODE	DWG NO	SIZE	REV
	REMOVE BURRS WELD SPLATTER & LOOSE SCALE							8052-24	DR-02-04	24A3993			
	REFERENCES ANSI Y14.5 & B46.1												
REV	DWG	CHK	ZONE	DATE	CHANGES								

D C B A


REV.	CHANGES	DATE	CHKD.	DATE

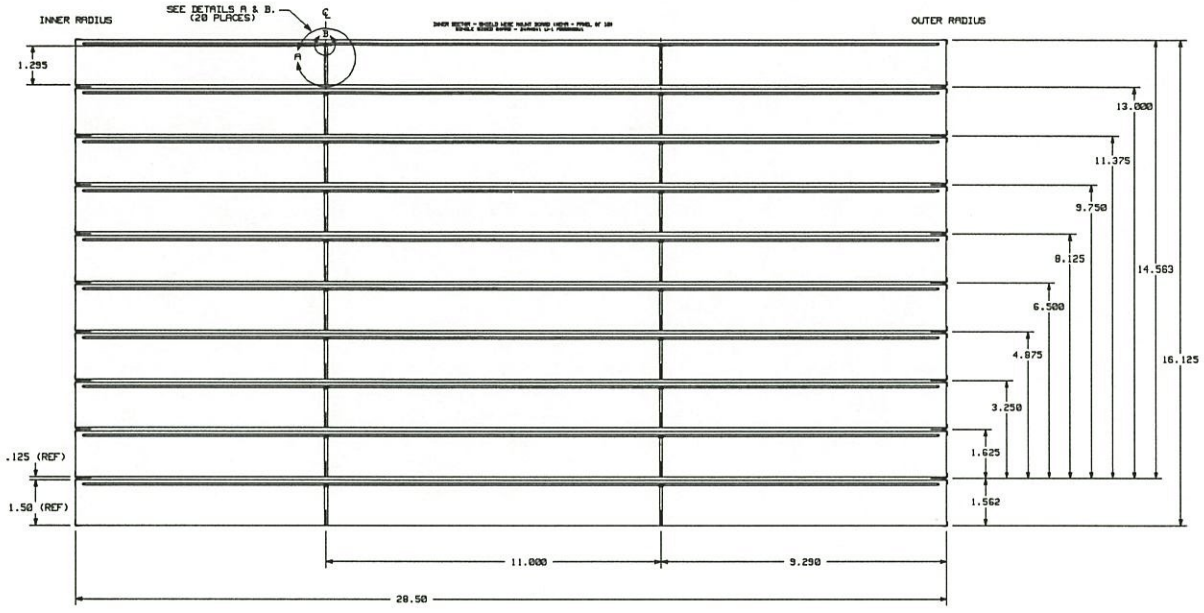


WIRE MOUNT SIDE VIEW
SCALE: ~5:1

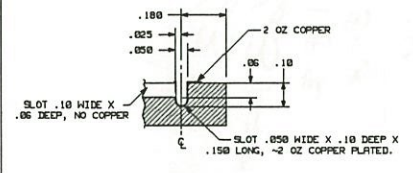


SECTION B-B
NO SCALE

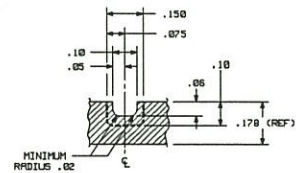

SECTION A-A
NO SCALE

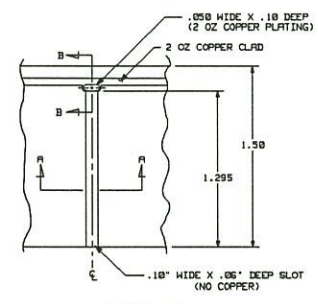

DETAIL A
NO SCALE

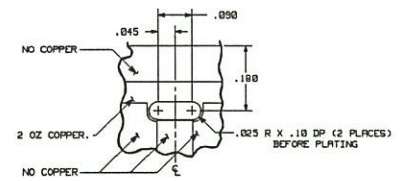

DETAIL B
NO SCALE

- NOTES:
- BOARD MATERIAL: .178 THICK NEPA G18, CERTIFIED BROMIDE FREE, 2 OZ. COPPER CLAD - ONE SIDE. THERE IS NO TIN PLATING ON THIS BOARD. MATERIAL WILL BE SUPPLIED BY LBL.
 - MANUFACTURER MAY NOT PUT ANY IDENTIFICATION NOMENCLATURE ON PRINTED CIRCUIT BOARD, EITHER SIDE.
 - BOARD SIZE IS 28.50 LONG X 1.50 WIDE X .178 THICK. DIMENSIONS ARE IN INCHES. TOLERANCES ARE .XX - .015 FND .XXX = .005.
 - CREATE SLOTS BEFORE COPPER PLATING.
 - FINAL ROUTING TO CREATE 10 INDIVIDUAL BOARDS.
 - REFERENCE DRAWINGS:
24A4533 M-1 BOARD OUTLINE/FABRICATION (SINGLE BOARD)
24A4534 SHIELD WIRE MOUNT BOARD (RIGHT SIDE-FINAL Pkg. FROM MECHANICAL DEPARTMENT)

1)	TITLE	STAR TPC
2)		INNER SECTOR ELECTRONICS
3)		SHIELD GRID WIRE MOUNT BOARD (NEPA-RT)
4)		BOARD OUTLINE/FABRICATION - PANEL OF 10
5)	PROJECT NUMBER	0052-24
6)	DESIGNED BY	WJ:22-28
7)	CHECKED BY	
8)	DATE	
9)	APPROVED BY	FRED BIESER
10)	FILE NO.	0000900m1
11)	SIZE	4
12)	REV.	24A4543 M-2
13)	SCALE	NONE
14)		E2,ES,L12,E19
15)		SHEET 2 OF 2

***** LBL BOARD A000900U1 *****
***** APRIL 06, 1995 *****
***** WHEEL W900INFO *****

NEED 1 STANDARD PHOTO PLOT, 1 POSITIVE AND 1 NEGATIVE.

FILM SIZE IS APPROXIMATELY 28.50 X 17.50 INCHES.

DELIVERY DATE: APRIL 11, 1995 OR SOONER.

PHOTO PLOT FILE IS IN POSITIVE FORMAT:

PL900U1 - SINGLE SIDED BOARD

PLEASE MAKE CONTACT COPIES OF PLOT FILE (1). I NEED ONE (1) POSITIVE
AND ONE (1) NEGATIVE, EMULSION DOWN, RIGHT READING.

IF THERE ARE ANY QUESTIONS OR PROBLEMS PLEASE CALL -JUDY- (916)
547-4005.

tr10 10 circle trace 10;
tr12 11 circle trace 12;
tr15 12 circle trace 15;
tr20 13 circle trace 20;
tr30 14 circle trace 30;
tr40 15 circle trace 40;
tr50 16 circle trace 50;
tr60 17 circle trace 60;
tr70 18 circle trace 70;
tr80 19 circle trace 80;
tr90 20 circle trace 90;
tr100 21 circle trace 100;
tr120 22 circle trace 120;
tr130 23 circle trace 130;
tr150 24 circle trace 150;
fl40 25 circle flash 40;
fl50 26 circle flash 50;
fl60 27 circle flash 60;
fl70 28 circle flash 70;
fl75 29 circle flash 75;
fl85 30 circle flash 85;
fl90 31 circle flash 90;
fl100 32 circle flash 100;
fl110 33 circle flash 110;
fl120 34 circle flash 120;
fl130 35 circle flash 130;
fl140 36 circle flash 140;
fl150 37 circle flash 150;
fl160 38 circle flash 160;
fl200 39 circle flash 200;
PADEX0 40 rectangle flash 80 55;
PADEX0 41 rectangle flash 55 80;
PADEXR 42 rectangle flash 75 55;
PADEXR 43 rectangle flash 55 75;
ftarget 44 square special 1.0;
fs60 45 square flash 60;
fs70 46 square flash 70;
fs75 47 square flash 75;
fs85 48 square flash 85;
fs100 49 square flash 100;
fs110 50 square flash 110;
fs120 51 square flash 120;
fs130 52 square flash 130;
fs140 53 square flash 140;
fs150 54 square flash 150;

PARTS LIST

TITLE: STAR TPC
 TEST ELECTRONICS
 SAS-16, AUTOTESTER DUT BOARD


FILE NO.: a000899c1 REV:
 PRINT NO.: 24A4531 C-1
 CHANGES (*):

ENGINEER: CHINH VU
 DRAFTER: STIRKKINEN


DATE: 03/13/95
 PAGE: 5 OF 6

Reference	Stock No.	Part Type	Description	Qty
** DIODES **				
CR10	NS	DJ1N4153	1N4153	1
** TRANSISTORS **				
Q1	5961-58000	QJ2N2219	2N2219A ,NPN ,Si ,40V ,800MV	1
Q2	5961-58001	QJ2N2905	2N2905A ,PNP ,Si ,60V ,600MV	1
Q3 ,Q4 ,Q8 ,Q9	NS	QSSD214	SD214 ,FET	4
Q5 ,Q7	5961-62037	QJ2N3906	2N3906 ,PNP ,TO-92	2
Q6	5961-65296	QJ2N3904	2N3904 ,NPN	1
** IC'S **				
U1 ,U2 ,U3 ,U4	5961-67615	ULSSD5000	SD5000N ,D-MOS FET QUAD ANALOG ,DIP (16)	4
U5	NS	SASCHIP	68 PIN ,PLCC ,LBL CHIP	1
U6 ,U7 ,U10 ,U11 ,U12 , U13	5961-66967	ULSOP27F	OP-27 ,OP-AMP LOW NOISE , DIP (8)	6
U8 ,U9 ,U31 ,U32	5961-70647	74HC4051	74HC4051 ,8 CHANNEL ANA- LOG MULTIPLEXER/DEMUL- TIPLEXER ,DIP (16)	4
U14	5961-70461	74HCT04	74HCT04 ,HEX INV ,TTL COM- PATIBLE ,DIP (14)	1
U15 ,U16 ,U17 ,U18 , U19 ,U20 ,U21 ,U22 , U23 ,U24 ,U25 ,U26 , U27 ,U28 ,U29 ,U30 , U39		ULSLM6161J	LM6161J ,OP-AMP ,DIP ,(8)	17
U33 ,U37		ULSLF353	LF353 ,OP-AMP ,DIP (8)	2
U35		ULSLM6164J	LM6164J ,OP-AMP ,DIP (8)	1
U36		ULSLM6162J	LM6162J ,OP-AMP ,DIP (8)	1
U43(U20) ,U44(U21)	5961-62970	75453	75453BN ,DUAL PERIPHERAL DRIVER ,NOR INP ,DIP (8)	2


REV.	CHANGES	DATE	CHKD.	DATE

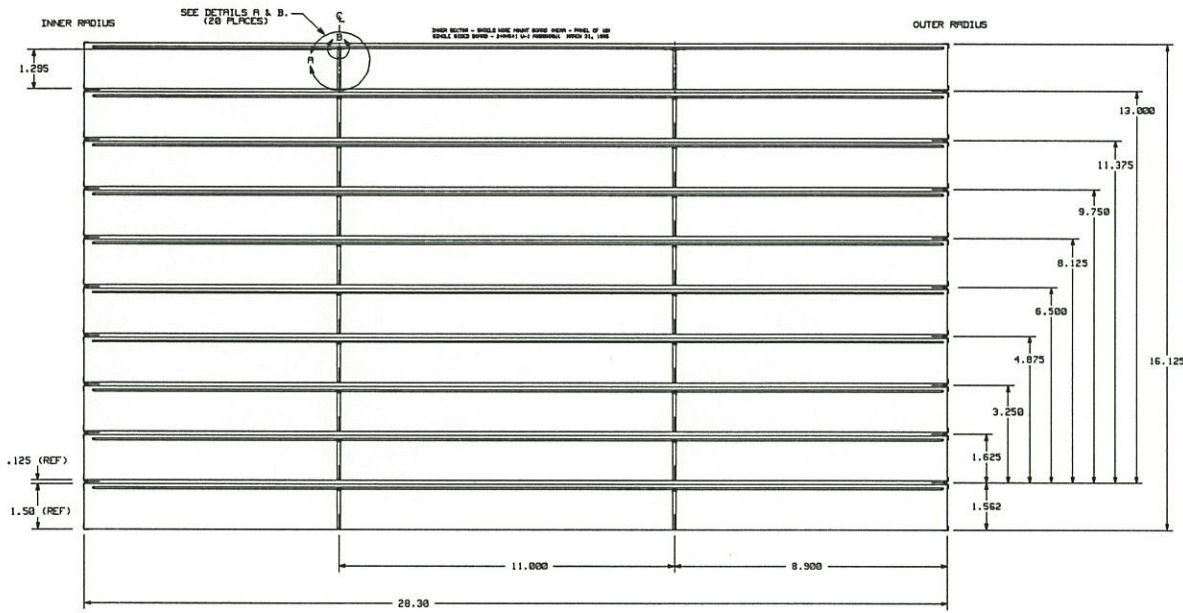


COPPER SIDE VIEW
SCALE: ~:5:1

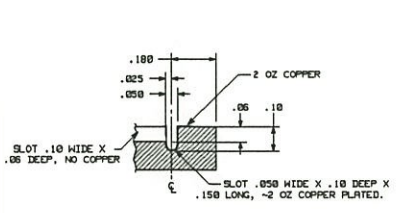


SECTION B-B
NO SCALE

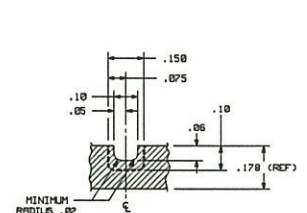

SECTION A-A
NO SCALE

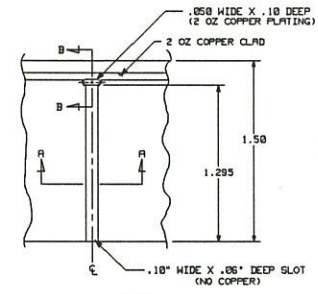

DETAIL A
NO SCALE

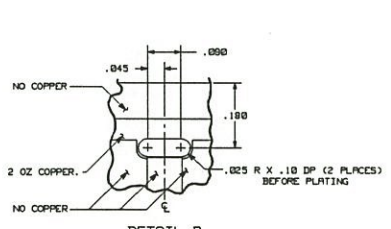


DETAIL B
NO SCALE


- NOTES:
- BOARD MATERIAL: .178 THICK NEMA G10, CERTIFIED BROMINE FREE, 2 OZ. COPPER CLAD - ONE SIDE. THERE IS NO TIN PLATING ON THIS BOARD. THIS IS A SINGLE SIDED BOARD. MATERIAL WILL BE SUPPLIED BY LBL.
 - MANUFACTURER MAY NOT PUT ANY IDENTIFICATION NOMENCLATURE ON PRINTED CIRCUIT BOARD, EITHER SIDE.
 - BOARD SIZE IS 28.50 LONG X 1.50 WIDE X .178 THICK. DIMENSIONS ARE IN INCHES. TOLERANCES ARE .XX = .015 FND .XXX = .005.
 - CREATE SLOTS BEFORE COPPER PLATING.
 - VERTICAL DIMENSIONS ARE CENTERS FOR A .125 BIT ROUTER. THIS WILL CREATE 10 INDIVIDUAL BOARD PER PANEL.
 - FINAL BOARD DIMENSIONS ARE 28.100 LONG X 1.389 WIDE X .178 THICK. SEE MECHANICAL DRAWING 24A434 FOR INSTRUCTIONS. FINAL ROUTING WILL BE DONE BY LBL.
 - REFERENCE DRAWINGS:
24A433 M-1 a000900m1 BOARD OUTLINE/FABRICATION (SINGLE BOARD-RIGHT,G10)
24A434 - SHIELD WIRE MOUNT BOARD (RIGHT,G10) FINAL FAB. DNG.

FILE	STAR TPC
DIR	INNER SECTOR ELECTRONICS
FILE	SHIELD GRID WIRE MOUNT BOARD (RIGHT,G10)
DIR	BOARD OUTLINE/FABRICATION - PANEL OF 10
DATE	0052-24
APP'D	DESIGNED
DATE	01/11/73
BY	LAWRENCE BERKELEY LABORATORY
BY	UNIVERSITY OF CALIFORNIA
BY	OFFICE OF ELECTRONICS ENGINEERING
BY	FILE NO.
BY	REV. NUMBER NO.
BY	4 24A4543 M-2
BY	DESIGNER FRED BIESER a000900m2
BY	SCALE NONE E2,E5,L12,E19


REV.	CHANGES	DRWNN	DATE	CHKD.	DATE

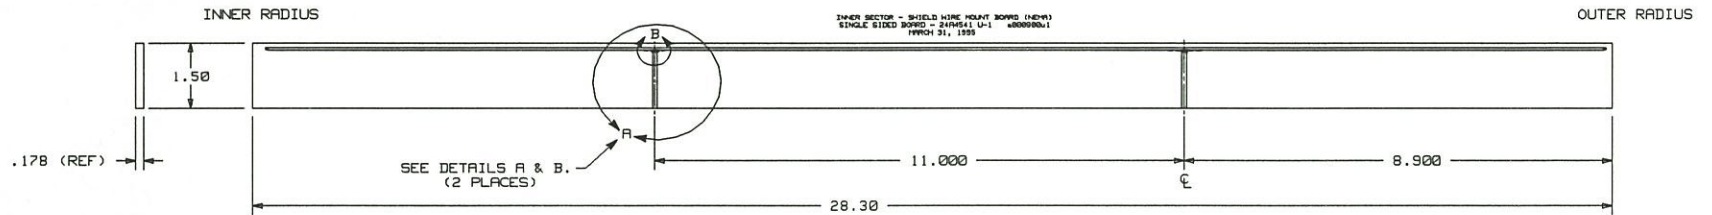


WIRE MOUNT SIDE VIEW
SCALE: ~.5:1

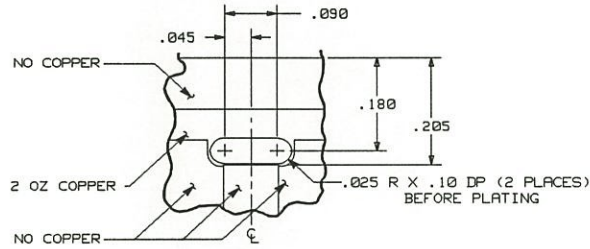


DETAIL B
NO SCALE

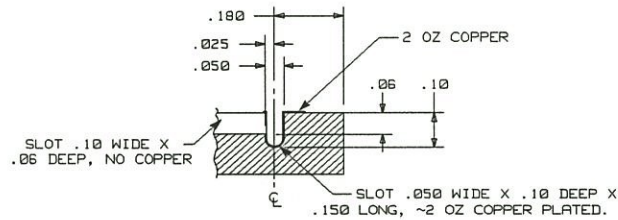

SECTION B-B
NO SCALE

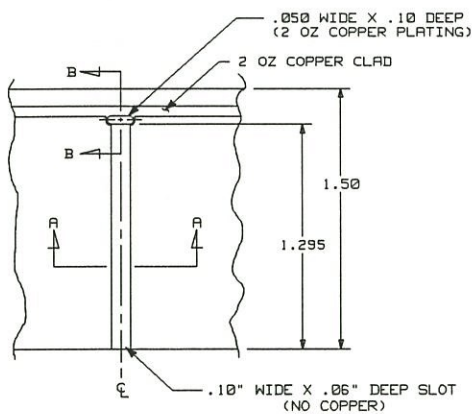

DETAIL A
NO SCALE

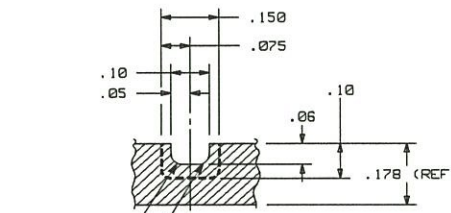

SECTION A-A
NO SCALE

NOTES:


- BOARD MATERIAL: .178 THICK NEMA G10, CERTIFIED BROMIDE FREE, 2 OZ. COPPER CLAD - ONE SIDE. THERE IS NO TIN PLATING ON THIS BOARD. THIS IS A SINGLE SIDED BOARD. MATERIAL WILL BE SUPPLIED BY LBL.
- MANUFACTURER MAY NOT PUT ANY IDENTIFICATION NOMENCLATURE ON PRINTED CIRCUIT BOARD, EITHER SIDE.
- BOARD SIZE IS 28.30 LONG X 1.50 WIDE X .178 THICK. DIMENSIONS ARE IN INCHES. TOLERANCES ARE .XX = .015 AND .XXX = .005.
- CREATE SLOTS BEFORE COPPER PLATING.
- FINAL BOARD DIMENSIONS ARE 28.100 LONG X 1.389 WIDE X .178 THICK. SEE DRAWING 24A4594 FOR ROUTING INSTRUCTIONS. FINAL ROUTING TO BE DONE BY LBL.
- REFERENCE DRAWINGS:
24A4534 M-2 a000900m2 BOARD OUTLINE/FABRICATION -
PANEL OF 10 BOARDS - RIGHT
SIDE - G10
24A4594 - SHIELD WIRE MOUNT BOARD
(RIGHT SIDE, G-10) FINAL
FAB. DRAWING

D	II	TITLE	STAR TPC		
I	III		INNER SECTOR ELECTRONICS		
S	III		SHIELD GRID WIRE MOUNT BOARD (RIGHT, G10)		
T	III		BOARD OUTLINE/FABRICATION		
SHOWN ON					
ACCOUNT NUMBER	8052-24	DATE	03/21/95	DATE	
SERIAL NUMBER		CHECKED		DATE	
DATE ISSUED		APPROVED		DATE	
DATE RECD.		NO. REGD.		FILE NO.	a000900m1
DEL. TO		ENGINEER	FRED BIESER	SIZE	3
				DRAWING NO.	24A4543 M-1
				REV.	
		SCALE	NONE	E2, E5, E12	SHEET 1 OF 2

REV.	CHANGES	DRAWN	DATE	CHKD.	DATE

PAD SIDE VIEW

SCALE: NONE

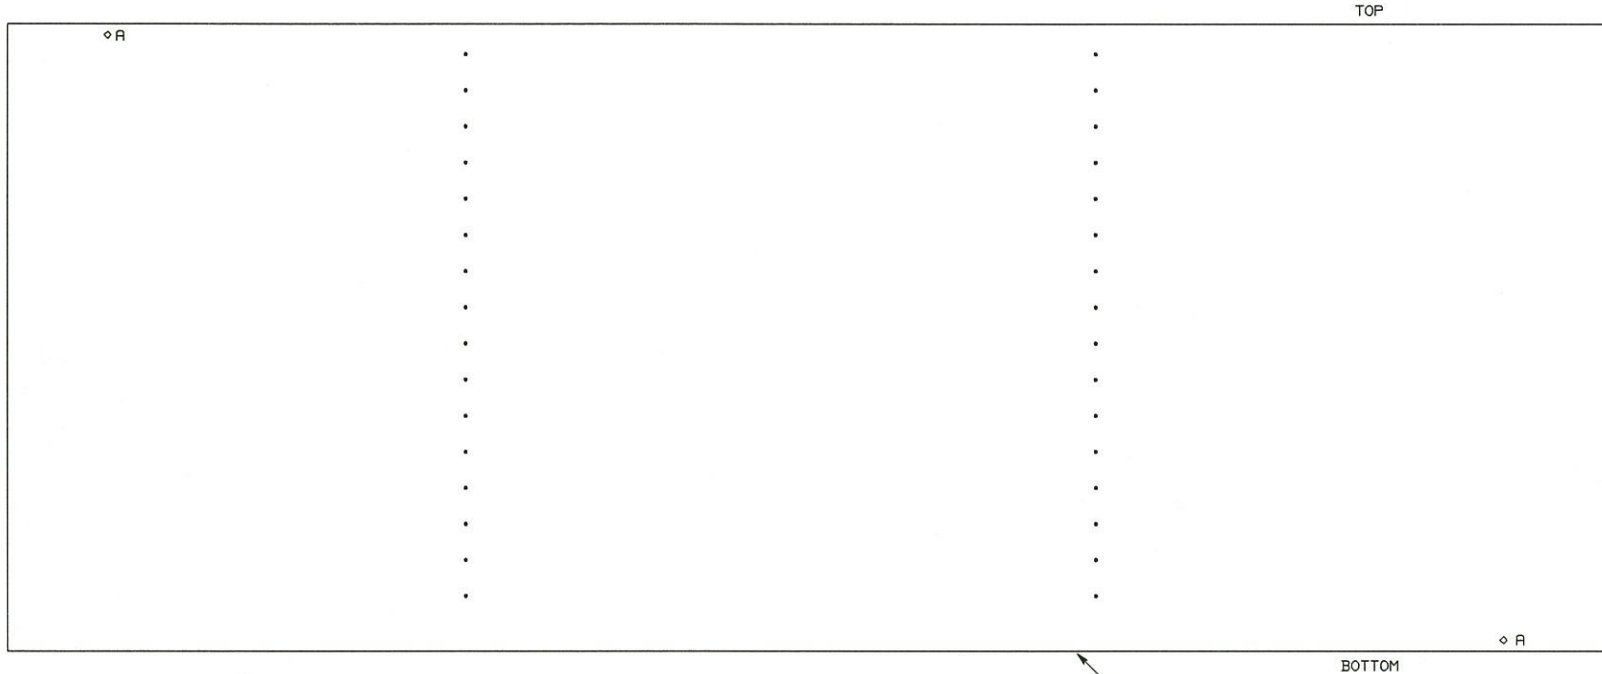

MANUFACTURER MAY PUT THEIR IDENTIFICATION NUMBER ON OUTER EDGES ONLY, TOP OR BOTTOM.

NOTES:

- BOARD MATERIAL: .005 THICK KAPTON WITH 1 OZ COPPER, BOTH SIDES. THERE IS NO TIN PLATING ON THIS BOARD.
- SEE HOLE SCHEDULE FOR HOLE SIZES.
- THIS BOARD TO BE THROUGH HOLE PLATED.
- SPECIFIED HOLE DIA. SIZES ARE FOR FINISHED HOLES AFTER PLATING.
- BOARD SIZE IS 11.125 +/- .010 X 28.100 +/- .005. SINGLE BOARD SIZE IS .515 X 28.100 +/- .005. DIMENSIONS ARE IN INCHES. BOARD OUTLINE DRAWING IS 24A3663 M-2 (a000893m2).
- SOLDERMASK IS NOT USED ON THIS BOARD.
- REFERENCE DRAWINGS:

24A3662 M-1	a000893m1	BOARD OUTLINE - SINGLE BOARD
24A3663 M-2	a000893m2	BOARD OUTLINE - PANEL OF 16 BOARDS
24A3662 E-1	a000893e1	HOLE SCHEDULE - SINGLE BOARD

HOLE SCHEDULE		
CODE	HOLE DIA.	COUNT
NONE	.028	32
A	.125	2

D I S T		TITLE		STAR TPC	
I:		INNER SECTOR ELECTRONICS			
II:		SHIELD GRID WIRE MOUNT BD (PANEL OF 16)			
III:		HOLE SCHEDULE - 24A3661 U-2 (A000893U2)			
SHOWN ON		ACCOUNT NUMBER		DRAWN	
		8052-24		STIRKINEN	
		DATE		DATE	
		4/1/94		LAWRENCE BERKELEY LABORATORY	
SERIAL NUMBER		CHECKED		DATE	
DATE ISSUED		NO. REGD.		APPROVED	
				DATE	
DATE RECD.		ENGINEER		FILE NO.	
		JIM HUNTER		a000893e2	
DEL. TO		SCALE		SIZE	
		NONE		3	
				DRAWING NO.	
				24A3663 E-2	
				REV.	
				E-2	
				SHEET 2 of 2	

$$\begin{array}{r}
 130 \\
 125 \\
 \hline
 255 \\
 1500 \\
 \hline
 1755
 \end{array}$$

$$\begin{array}{r}
 28240 \\
 500 \\
 \hline
 81740
 \end{array}$$

9033


-1370

1	2	3	100
---	---	---	---	---	---	---	---	---	----	----	-----

100%
 90%
 80%
 70%
 60%
 50%
 40%
 30%
 20%
 10%
 0%

REV.	CHANGES	DRAWN	DATE	CHKD.	DATE

TRACE SIDE VIEW
SCALE: NONE

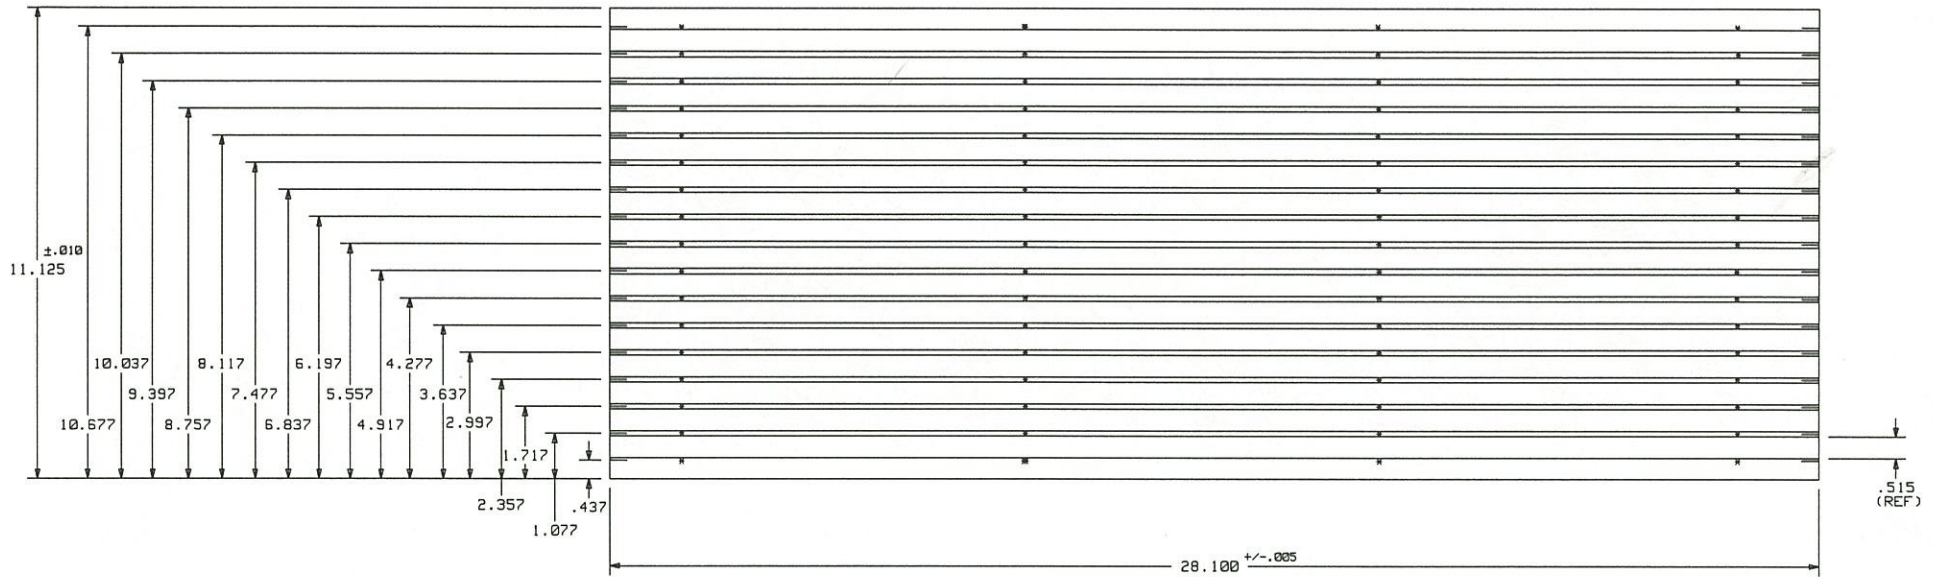


NOTES:

- BOARD MATERIAL: .005 KAPTON WITH 1 OZ COPPER, BOTH SIDES. THERE IS NO TIN PLATING ON THIS BOARD. TOTAL THICKNESS NOT TO EXCEED .009".
- BOARD PANEL SIZE IS 11.125 +/- .010 X 28.100 +/- .005. SINGLE BOARD SIZE IS .515 +/- .005 X 28.100 +/- .005. DIMENSIONS ARE IN INCHES. UNLISTED TOLERANCES ARE +/- .005.
- * = APPROXIMATE PLACEMENT OF .050 TABS. SLOTS TO BE .125 WIDE.
- REFERENCE DRAWINGS:
 24A3662 E-1 a000893e1 HOLE SCHEDULE - SINGLE BOARD
 24A3663 E-2 a000893e2 HOLE SCHEDULE - PANEL OF 16 BOARDS
 24A3662 M-1 a000893m1 BOARD OUTLINE - SINGLE BOARD

D I S T		TITLE		STAR TPC	
II:		INNER SECTOR ELECTRONICS			
III:		SHIELD GRID WIRE MOUNT BD (PANEL OF 16)			
SHOWN ON		BOARD OUTLINE - 24A3661 U-2 (A000893U2)			
ACCOUNT NUMBER	8052-24	DRAWN	STIRKINEN	DATE	4/01/84
SERIAL NUMBER		CHECKED		DATE	
DATE ISSUED		APPROVED		DATE	
DATE RECD.		ENGINEER	THOMAS NOGGLE	FILE NO.	a000893m2
DEL. TO		SCALE	NONE	SIZE	3
				DRAWING NO.	24A3663 M-2
				REV.	
					SHEET 2 of 2

REV.	CHANGES	DRAWN	DATE	CHKD.	DATE

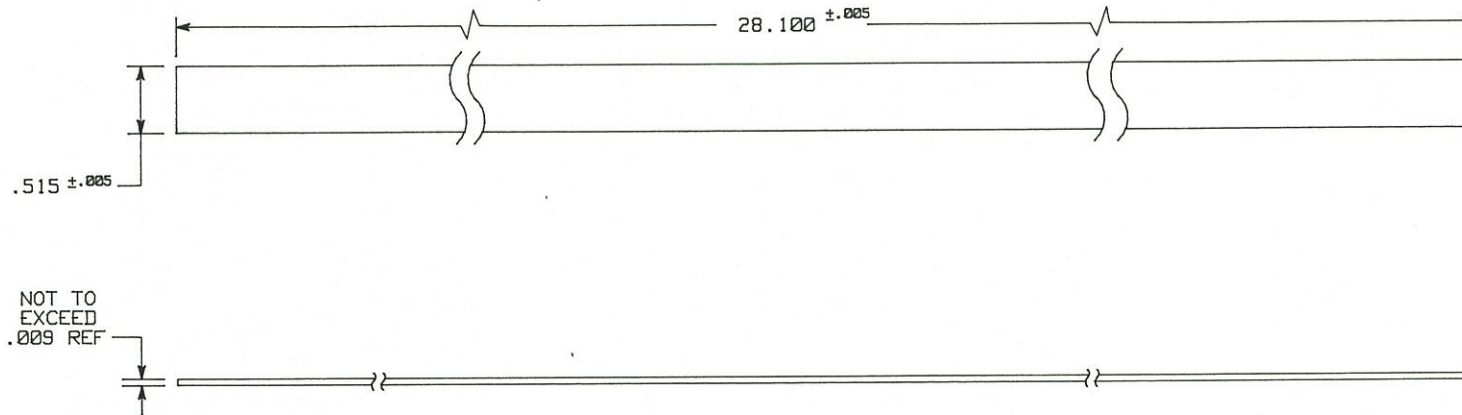


NOTES:

- BOARD MATERIAL: .005 KAPTON WITH 1 OZ COPPER, BOTH SIDES; THERE IS NO TIN PLATING ON THIS BOARD. BOARD THICKNESS NOT TO EXCEED .009".
- DIMENSIONS ARE IN INCHES.
- BOARD SIZE IS .515 +/- .005 X 28.100 +/- .005.
- REFERENCE DRAWINGS:
24A3662 E-1 a000893e1 HOLE SCHEDULE - SINGLE BOARD
24A3663 E-2 a000893e2 HOLE SCHEDULE - PANEL OF 16 BOARDS
24A3663 M-2 a000893m2 BOARD OUTLINE - PANEL OF 16 BOARDS

D I S T	I:	TITLE STAR TPC				
	II:	INNER SECTOR ELECTRONICS				
	III:	INNER-SHIELD WIRE MOUNT BOARD(SINGLE BD)				
SHOWN ON		BOARD OUTLINE - 24A3661 U-1 (A000893U1)				
ACCOUNT NUMBER	8052-24	DRAWN	DATE	LAWRENCE BERKELEY LABORATORY		
SERIAL NUMBER		STIRKKINEN	3/31/94	UNIVERSITY OF CALIFORNIA		
DATE ISSUED	NO. REQD.	CHECKED	DATE	OFFICE OF ELECTRONICS ENGINEERING		
DATE REQD.		APPROVED	DATE	FILE NO.	SIZE	
		ENGINEER	JIM HUNTER	a000893m1	2	
DEL. TO		SCALE	NONE	E2	DRAWING NO.	
					24A3662 M-1	
					REV.	
					SHEET 1 OF 2	

REV.	CHANGES	DRAWN	DATE	CHKD.	DATE


PAD VIEW

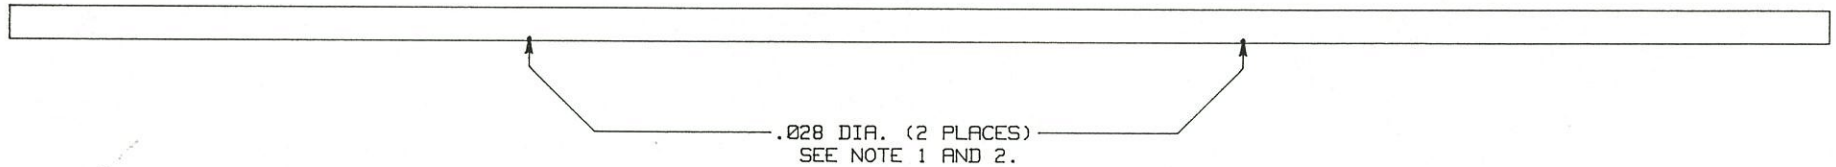

NOTES:

1. BOARD MATERIAL: .005 THICK KAPTON WITH 1 OZ COPPER, BOTH SIDES. THERE IS NO TIN PLATING ON THIS BOARD.
2. MANUFACTURER MAY NOT PUT ANY IDENTIFICATION NOMENCLATURE ON PRINTED CIRCUIT BOARD, EITHER SIDE.
3. THIS BOARD TO BE THROUGH HOLE PLATED.
4. SPECIFIED HOLE DIA. SIZE IS FOR FINISHED HOLES AFTER PLATING.
5. BOARD SIZE IS .515 +/- .005 X 28.100 +/- .005. DIMENSIONS ARE IN INCHES. BOARD OUTLINE DRAWING IS 24A3662 M-1 (a000893m1).
6. SOLDERMASK IS NOT USED ON THIS BOARD.
7. REFERENCE DRAWINGS:
 24A3662 M-1 a000893m1 BOARD OUTLINE - SINGLE BOARD
 24A3663 M-2 a000893m2 BOARD OUTLINE - PANEL OF 16 BOARDS
 24A3663 E-2 a000893e2 HOLE SCHEDULE - PANEL OF 16 BOARDS

D I S T		TITLE		STAR TPC	
		II:		INNER SECTOR ELECTRONICS	
		III:		SHIELD GRID WIRE MOUNT BD (SINGLE BOARD)	
SHOWN ON		HOLE SCHEDULE - 24A3661 U-1 (A000893U1)			
ACCOUNT NUMBER	8052-24	DRAWN	DATE	LAWRENCE BERKELEY LABORATORY	
SERIAL NUMBER		STIRKKINEN	4/1/84	UNIVERSITY OF CALIFORNIA	
DATE ISSUED	NO. REQD.	CHECKED	DATE	OFFICE OF ELECTRONICS ENGINEERING	
DATE REQD.		APPROVED	DATE	FILE NO.	REV.
		ENGINEER		a000893e1	2
		THOMAS NOGGLE		DRAWING NO.	24A3662 E-1
DEL. TO		SCALE	NONE	E2, C3	SHEET 1 OF 2

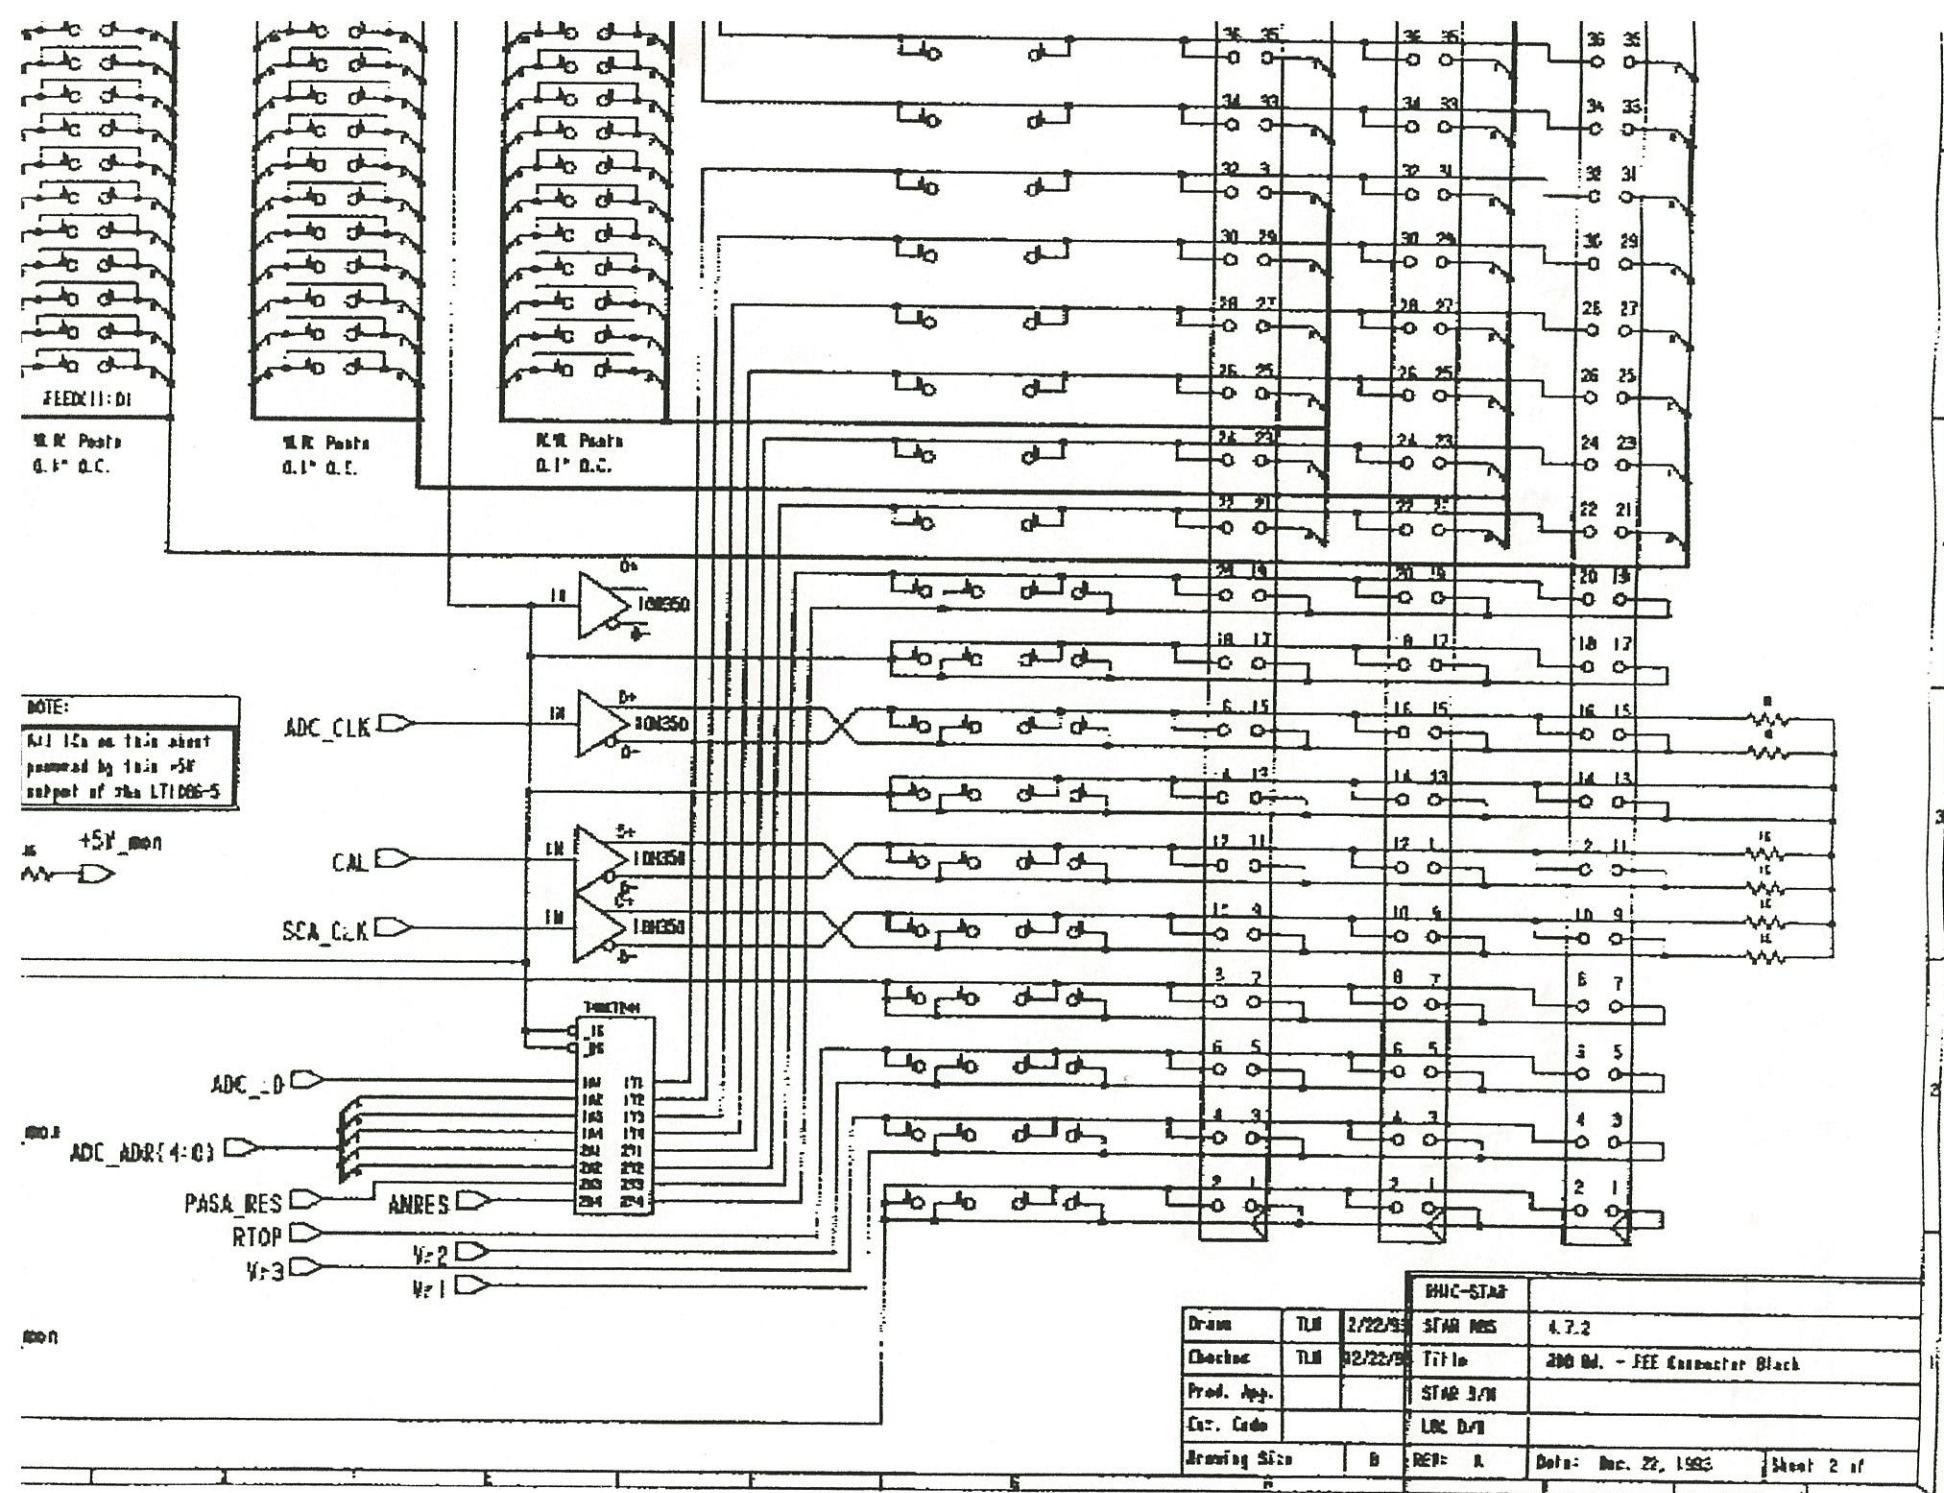

NOTE:
All ICs on this sheet powered by this -5V output of the LT1006-5

+5V_mon
AV

MON
ADC_ADR(4-B)

MON

		BHC-STAR		
Drawn	TJM	2/22/93	STAR RES	4.7.2
Checked	TJM	02/22/93	Title	200 Bd. - FEE Connector Block
Prod. App.			STAR 3/W	
Est. Code			LOC D/W	
Drawing Size	B	REP: A	Date: Dec. 22, 1993	Sheet 2 of

ORIGIN: -100, ~~100~~

a000893u2 24A3661 U-1
SHIELD GRID WIRE MOUNT (PANEL OF 16)

INNER SECTOR

LAYER 1 ⇒ TRACKS & PADS ⇒ #E5 #E29 - P29 #E55 #E9 = a89311

CM0893L1 = A893L1 =

LAYER 2 ⇒ PADS ONLY ⇒ #E19 #E29 - P29 #E55 = a89312-g

CM0893L2 = A893L2 =

DRILL ⇒ #C1 #E56 = a893dr-g

***** LBL BOARD A000893U2 *****
***** MAY 17, 1994 *****
***** WHEEL W893INFO *****

NEED 2 STANDARD PHOTOPLOTS, 2 POSITIVES AND 2 NEGATIVES.
FILM SIZE IS APPROXIMATELY 28.300 X 12.400 INCHES.
DELIVERY DATE: MAY 19, 1994 OR SOONER.

PHOTOPLOT FILES IN POSITIVE FORMAT:

PL893L1 - LAYER 1 SOLDER SIDE

PL893L2 - LAYER 2 PADS ONLY

PLEASE MAKE CONTACT COPIES OF PLOT FILES (2). I NEED ONE (1) POSITIVE
AND ONE (1) NEGATIVE OF EACH FILE, EMULSION DOWN, RIGHT READING.


THIS IS A TOTAL OF TWO (2) POSITIVES AND TWO (2) NEGATIVES.

IF THERE ARE ANY QUESTIONS OR PROBLEMS PLEASE CALL -JUDY- (916)


547-4005 OR -JIM- (510)486-7084.

tr10 10 circle trace 10;
tr12 11 circle trace 12;
tr15 12 circle trace 15;
tr20 13 circle trace 20;
tr30 14 circle trace 30;
tr40 15 circle trace 40;
tr50 16 circle trace 50;
tr60 17 circle trace 60;
tr70 18 circle trace 70;
tr80 19 circle trace 80;
tr90 70 circle trace 90;
tr100 71 circle trace 100;
tr120 20 circle trace 120;
tr130 21 circle trace 130;
tr150 22 circle trace 150;
fl40 23 circle flash 40;
fl50 24 circle flash 50;
fl60 25 circle flash 60;
fl70 26 circle flash 70;
fl75 27 circle flash 75;
fl85 28 circle flash 85;
fl90 29 circle flash 90;
fl100 72 circle flash 100;
fl110 73 circle flash 110;
fl120 30 circle flash 120;
fl130 31 circle flash 130;
fl140 32 circle flash 140;
fl150 33 circle flash 150;
fl160 34 circle flash 160;
fl200 35 circle flash 200;
PADEXO 36 oval flash 75 55;
PADEXO 37 oval flash 55 75;
PADEXR 38 rectangle flash 75 55;
PADEXR 39 rectangle flash 55 75;
ftarget 40 square special 1.0;
fs45 41 square flash 45;
fs70 42 square flash 70;
fs75 43 square flash 75;
fs85 44 square flash 85;
fs100 45 square flash 100;
fs110 46 square flash 110;
fs120 47 square flash 120;
fs130 48 square flash 130;
fs140 49 square flash 140;
fs150 50 square flash 150;

a 00Q 893w1

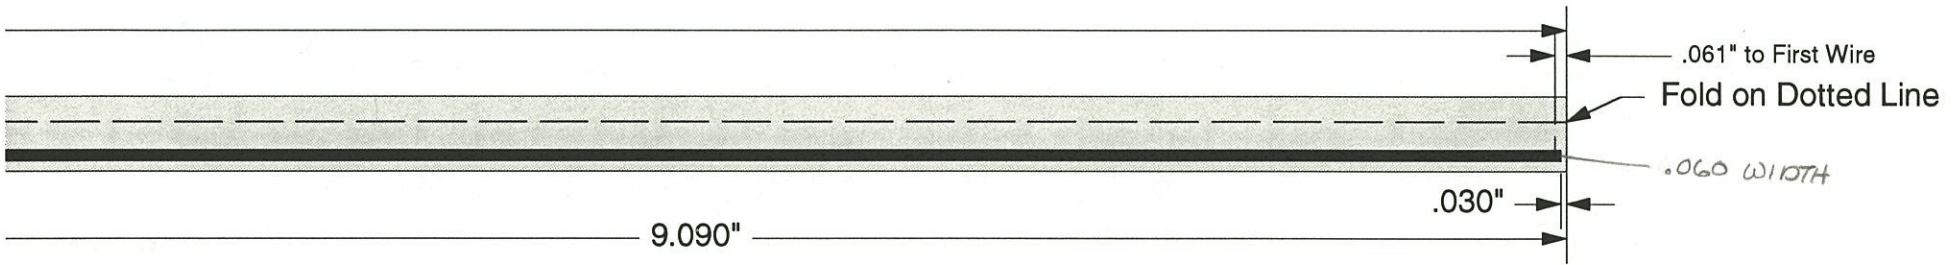


Outer Radius

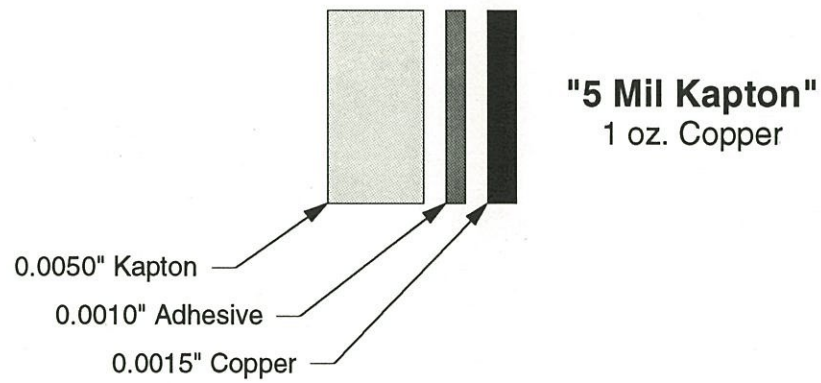


a000893u1

24A3661

STAR Shield Grid Wire Mount P.C.B., Inner Sector

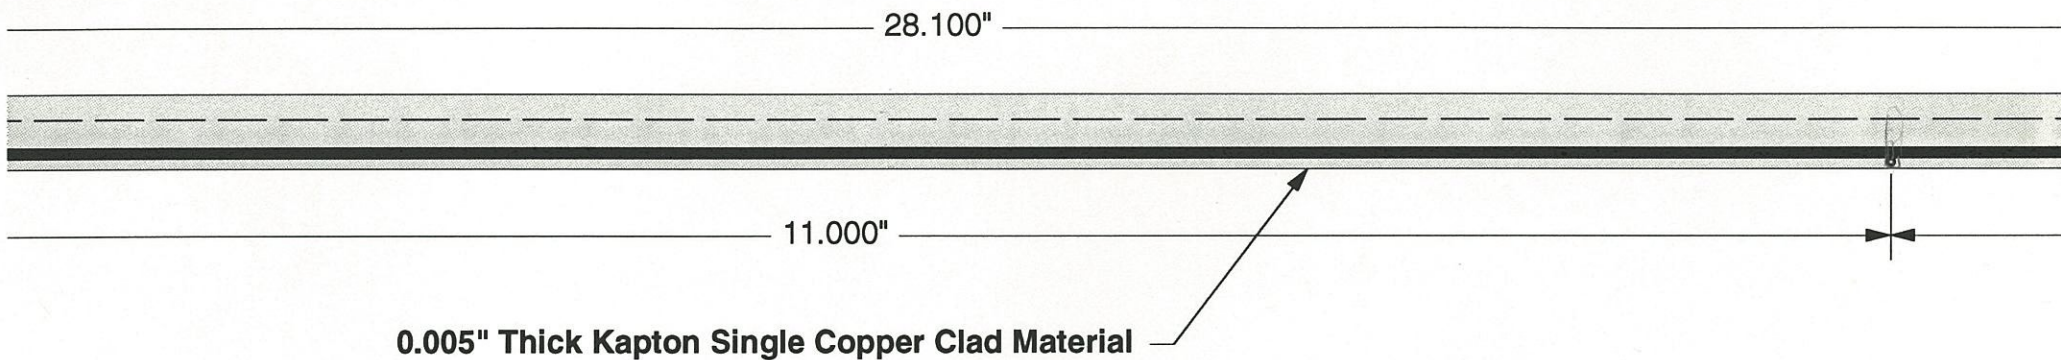

10.95

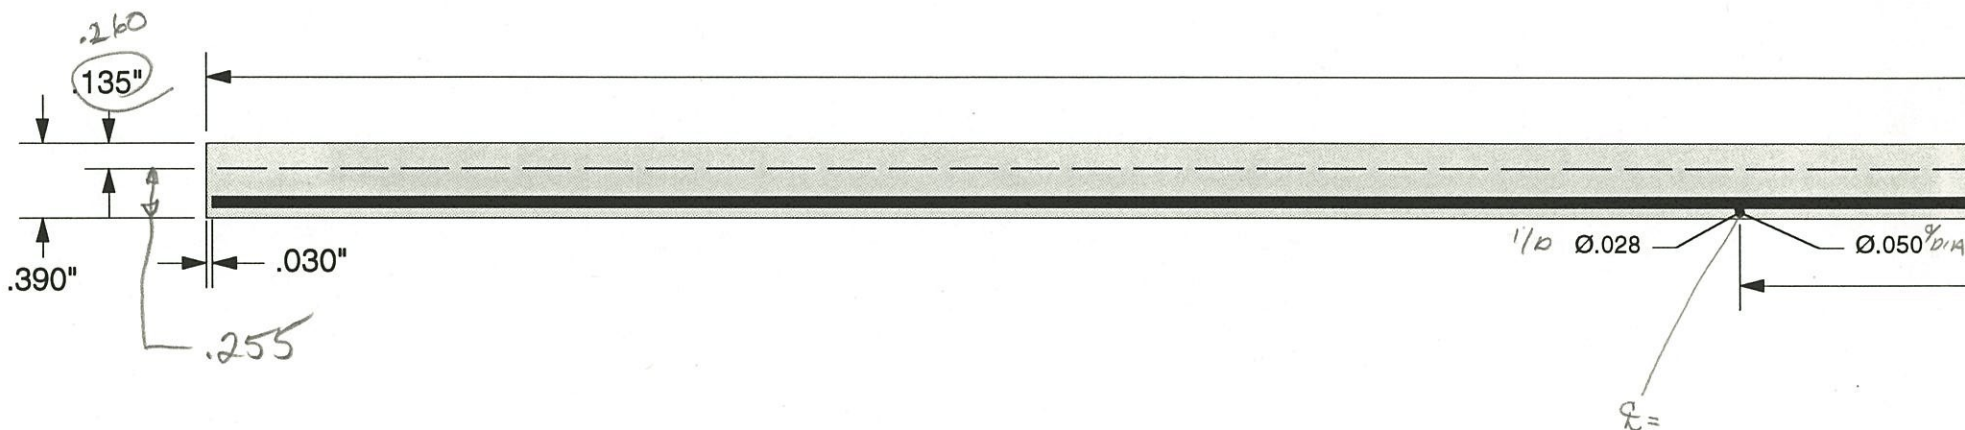

Inner Radius

$$\begin{array}{r} 390 \\ 135 \\ \hline 255 \end{array}$$

.390
.125
.515
JOHN WIRTH
4/15/94

$$\begin{array}{r} 135 \\ 125 \\ \hline 260 \end{array}$$

PRINT LIST

TITLE: STAR TPC
INNER SECTOR ELECTRONICS
SHIELD GRID WIRE MOUNT BOARD
(PANEL OF 16 BOARDS)

FILE NO.: a000893p1 REV:
PRINT NO.: 24A3661 P-1
CHANGES (*)

ENGINEER: JIM HUNTER
DRAFTER: STIRKKINEN

DATE: 04/01/94
PAGE: 1 OF 1


Drawing No.	Chg. Ltr.	Title
24A3662 M-1 (a000893m1)		BOARD OUTLINE - SINGLE BOARD
24A3663 M-2 (a000893m2)		BOARD OUTLINE - PANEL OF 16
24A3662 E-1 (a000893e1)		HOLE SCHEDULE - SINGLE BOARD
24A3663 E-2 (a000893e2)		HOLE SCHEDULE - PANEL OF 16
24A3661 U-1 (a000893u1)		ARTWORK - SINGLE BOARD
24A3661 U-2 (a000893u2)		ARTWORK - PANEL OF 16 24A3661 U-1'S

** THE FOLLOWING DRAWINGS NOT REQUIRED FOR THIS PACKAGE:
PARTS LIST, SILKSCREEN, PC BOARD ASSEMBLY

NUMBERS WITHIN () REFER TO EGS COMPUTER FILES

JIM HUNTER
77059

REV.	CHANGES	DRAWN	DATE	CHKD.	DATE

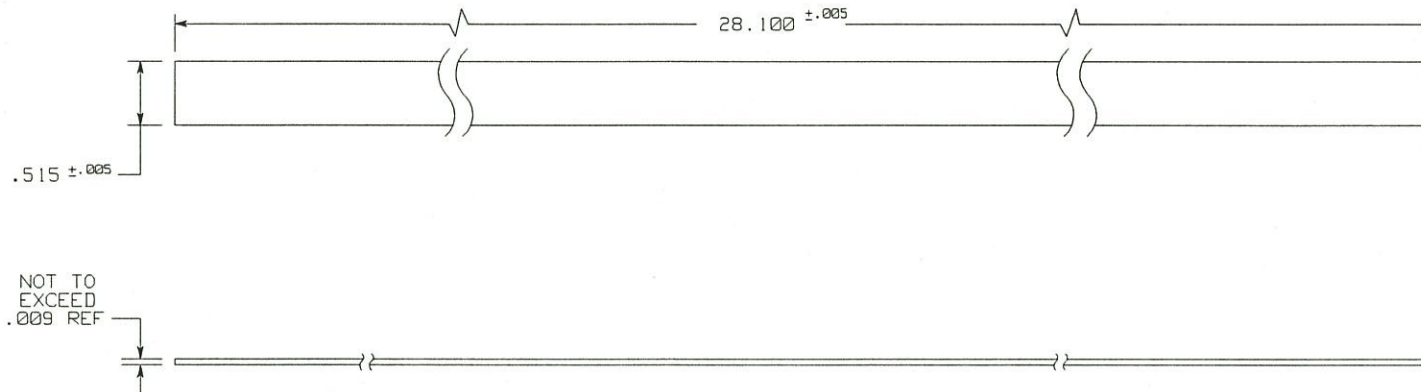

NOTES:

- BOARD MATERIAL: .005 KAPTON WITH 1 OZ COPPER, BOTH SIDES; THERE IS NO TIN PLATING ON THIS BOARD. BOARD THICKNESS NOT TO EXCEED .009".
- DIMENSIONS ARE IN INCHES.
- BOARD SIZE IS .515 +/- .005 X 28.100 +/- .005.
- REFERENCE DRAWINGS:
 24A3662 E-1 a000893e1 HOLE SCHEDULE - SINGLE BOARD
 24A3663 E-2 a000893e2 HOLE SCHEDULE - PANEL OF 16 BOARDS
 24A3663 M-2 a000893m2 BOARD OUTLINE - PANEL OF 16 BOARDS

D I S T	I:	TITLE STAR TPC											
	II:	INNER SECTOR ELECTRONICS											
	III:	INNER-SHIELD WIRE MOUNT BOARD(SINGLE BD)											
SHOWN ON		BOARD OUTLINE - 24A3661 U-1 (A000893U1)											
ACCOUNT NUMBER	8052-24	DRAWN	STIRKKINEN	DATE	3/31/94	LAWRENCE BERKELEY LABORATORY UNIVERSITY OF CALIFORNIA OFFICE OF ELECTRONICS ENGINEERING							
SERIAL NUMBER		CHECKED		DATE									
DATE ISSUED		APPROVED		DATE		FILE NO.	a000893m1	SIZE	2	DRAWING NO.	24A3662 M-1	REV.	
DATE RECD.		ENGINEER	JIM HUNTER										
DEL. TO		SCALE	NONE			E2						SHEET 1 OF 2	

REV.	CHANGES	DRAWN	DATE	CHK'D.	DATE

TRACE SIDE VIEW
SCALE: NONE




NOTES:

- BOARD MATERIAL: .005 KAPTON WITH 1 OZ COPPER, BOTH SIDES. THERE IS NO TIN PLATING ON THIS BOARD. TOTAL THICKNESS NOT TO EXCEED .009".
- BOARD PANEL SIZE IS 11.125 ± .010 X 28.100 ± .005. SINGLE BOARD SIZE IS .515 ± .005 X 28.100 ± .005. DIMENSIONS ARE IN INCHES. UNLISTED TOLERANCES ARE ± .005.
- * = APPROXIMATE PLACEMENT OF .050 TABS. SLOTS TO BE .125 WIDE.
- REFERENCE DRAWINGS:
 24A3662 E-1 a000893e1 HOLE SCHEDULE - SINGLE BOARD
 24A3663 E-2 a000893e2 HOLE SCHEDULE - PANEL OF 16 BOARDS
 24A3662 M-1 a000893m1 BOARD OUTLINE - SINGLE BOARD

D I:		TITLE		STAR TPC	
S I:		DRAWN		STIRKKINEN	
T I:		DATE		4/31/94	
S I:		CHECKED		DATE	
S I:		DATE		DATE	
S I:		APPROVED		DATE	
S I:		ENGINEER		THOMAS NOGGLE	
S I:		FILE NO.		a000893m2	
S I:		SIZE		3	
S I:		DRAWING NO.		24A3663 M-2	
S I:		SCALE		NONE	
S I:		E2		SHEET 2 of 2	

REV.	CHANGES	DRAWN	DATE	CHKD.	DATE

PAD VIEW

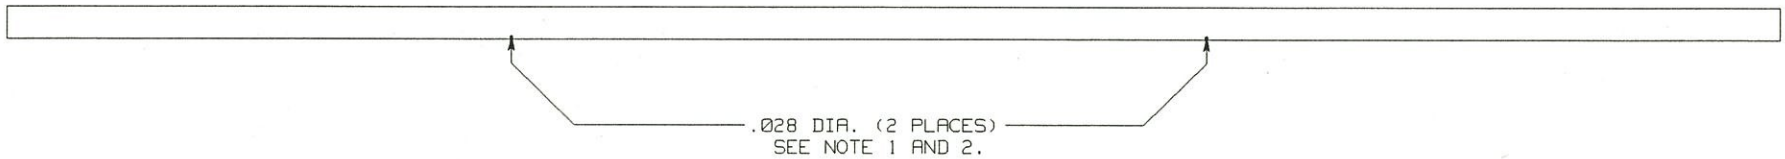

NOTES:

- BOARD MATERIAL: .005 THICK KAPTON WITH 1 OZ COPPER, BOTH SIDES. THERE IS NO TIN PLATING ON THIS BOARD.
- MANUFACTURER MAY NOT PUT ANY IDENTIFICATION NOMENCLATURE ON PRINTED CIRCUIT BOARD, EITHER SIDE.
- THIS BOARD TO BE THROUGH HOLE PLATED.
- SPECIFIED HOLE DIA. SIZE IS FOR FINISHED HOLES AFTER PLATING.
- BOARD SIZE IS .515 +/- .005 X 28.100 +/- .005. DIMENSIONS ARE IN INCHES. BOARD OUTLINE DRAWING IS 24A3662 M-1 (a000893m1).
- SOLDERMASK IS NOT USED ON THIS BOARD.
- REFERENCE DRAWINGS:


24A3662 M-1	a000893m1	BOARD OUTLINE - SINGLE BOARD
24A3663 M-2	a000893m2	BOARD OUTLINE - PANEL OF 16 BOARDS
24A3663 E-2	a000893e2	HOLE SCHEDULE - PANEL OF 16 BOARDS

D I S T	I:	TITLE STAR TPC											
	II:	INNER SECTOR ELECTRONICS											
	III:	SHIELD GRID WIRE MOUNT BD (SINGLE BOARD)											
SHOWN ON	HOLE SCHEDULE - 24A3661 U-1 (A000893U1)												
ACCOUNT NUMBER	8052-24	DRAWN	STIRKKINEN	DATE	4/1/94	LAWRENCE BERKELEY LABORATORY UNIVERSITY OF CALIFORNIA OFFICE OF ELECTRONICS ENGINEERING							
SERIAL NUMBER		CHECKED		DATE									
DATE ISSUED		NO. REOD.		APPROVED		FILE NO.		SIZE		DRAWING NO.		REV.	
DATE REOD.				ENGINEER	THOMAS NOGGLE	a000893e1	2			24A3662 E-1			
DEL. TO		SCALE	NONE			E2,C3						SHEET	1 OF 2

REV.	CHANGES	DRAWN	DATE	CHKD.	DATE

PAD SIDE VIEW

SCALE: NONE

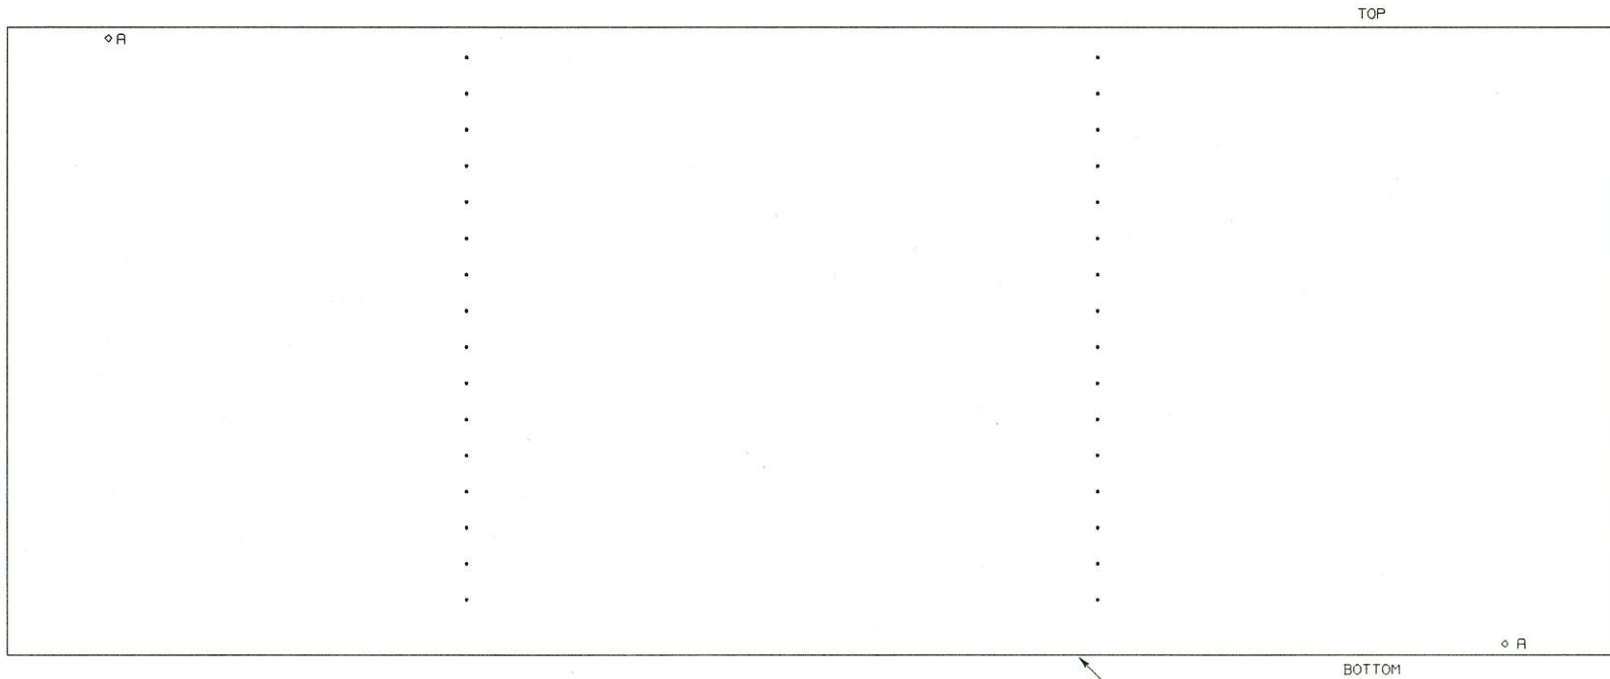

MANUFACTURER MAY PUT THEIR IDENTIFICATION NUMBER ON OUTER EDGES ONLY, TOP OR BOTTOM.

NOTES:

- BOARD MATERIAL: .005 THICK KAPTON WITH 1 OZ COPPER, BOTH SIDES. THERE IS NO TIN PLATING ON THIS BOARD.
- SEE HOLE SCHEDULE FOR HOLE SIZES.
- THIS BOARD TO BE THROUGH HOLE PLATED.
- SPECIFIED HOLE DIA. SIZES ARE FOR FINISHED HOLES AFTER PLATING.
- BOARD SIZE IS 11.125 +/- .010 X 28.100 +/- .005. SINGLE BOARD SIZE IS .515 X 28.100 +/- .005. DIMENSIONS ARE IN INCHES. BOARD OUTLINE DRAWING IS 24A3663 M-2 (A000893m2).
- SOLDERMASK IS NOT USED ON THIS BOARD.
- REFERENCE DRAWINGS:
 24A3662 M-1 A000893m1 BOARD OUTLINE - SINGLE BOARD
 24A3663 M-2 A000893m2 BOARD OUTLINE - PANEL OF 16 BOARDS
 24A3662 E-1 A000893e1 HOLE SCHEDULE - SINGLE BOARD

HOLE SCHEDULE		
CODE	HOLE DIA.	COUNT
NONE	.028	32
A	.125	2

I:		TITLE		STAR TPC	
II:		INNER SECTOR ELECTRONICS			
III:		SHIELD GRID WIRE MOUNT BD (PANEL OF 16)			
IV:		HOLE SCHEDULE - 24A3661 U-2 (A000893U2)			
ACQUANT NUMBER	8052-24	DRAWN	STIRKKINEN	DATE	4/1/94
SERIAL NUMBER		CHECKED		DATE	
DATE ISSUED		APPROVED		DATE	
DATE REC'D.		ENGINEER	JIM HUNTER	FILE NO.	A000893e2
DEL. TO		SCALE	NONE	SIZE	3
		DRAWING NO.	24A3663	REV.	E-2
		C1,C3,E14		SHEET 2 of 2	

PRINT LIST

TITLE: STAR TPC
INNER SECTOR ELECTRONICS
LITTLE ORPHAN ANODE BOARD
(PANEL OF 10 24A4511 U-1,
a000897u1)

FILE NO.: a000897p1 REV:
PRINT NO.: 24A4511 P-1
CHANGES (*)

ENGINEER: JIM HUNTER
DRAFTER: STIRKKINEN

DATE: 04/15/94
PAGE: 1 OF 1

Drawing No.	Chg. Ltr.	Title
-----	-----	-----
24A4511 C-1 (a000897c1)		PARTS LIST (PANEL)
24A4512 M-1 (a000897m1)		BOARD OUTLINE (PANEL)
24A4512 E-1 (a000897e1)		HOLE SCHEDULE (PANEL)
24A4512 L-1 (a000897l1)		PC BOARD ASSEMBLY (PANEL)
24A4511 U-1 (a000897u1)		PC BOARD - ISOR/10 WIRE (SINGLE BOARD)
24A4511 U-2 (a000897u2)		PC BOARD - ISOR/10 WIRE (PANEL)

** DRAWINGS NOT REQUIRED FOR THIS PACKAGE - SILKSCREEN **

NUMBERS WITHIN () REFER TO EGS COMPUTER FILES

* PARTS LIST

TITLE: STAR TPC
 INNER SECTOR ELECTRONICS
 LITTLE ORPHAN ANODE BOARD
 (PANEL OF 10 BOARDS)


FILE NO.: a000897c1 REV:
 PRINT NO.: 24A4511 C-1
 CHANGES (*)

ENGINEER: JIM HUNTER
 DRAFTER: STIRKKINEN

DATE: 04/15/94
 PAGE: 1 OF 1

Reference	Stock No.	Part Type	Description	Qty
CAPACITORS				
C1, C2, C3, C4, C5, C6, C7, C8, C9, C10, C11	NS	.001uF	.001uF, 3KV, CERAMIC, SMT, SIZE .120 X .180	110
RESISTORS				
R1, R2, R3, R4, R5, R6, R7, R8, R9, R10, R11	NS	10M	10M, 1/8W, 5%, SMT, SIZE	110
MISCELLANEOUS				
J1	NS	CN11SROW	11 PIN, SINGLE ROW CON- NECTOR, STRAIGHT, SAMTEC #SSK-111-S-G, SOLDER TAIL	10
-	NS	CN1SROW	1 PIN, SINGLE ROW CON- NECTOR, STRAIGHT, SAMTEC #SSK-101-S-G, SOLDER TAIL	4
-	NS	24A4511 U-2 (a000897u2)	24A4511 U-2, PC BD, PANEL OF 10 BOARDS (24A4511 U-1 , a000897u1)	1

COMPONENT SIDE VIEW

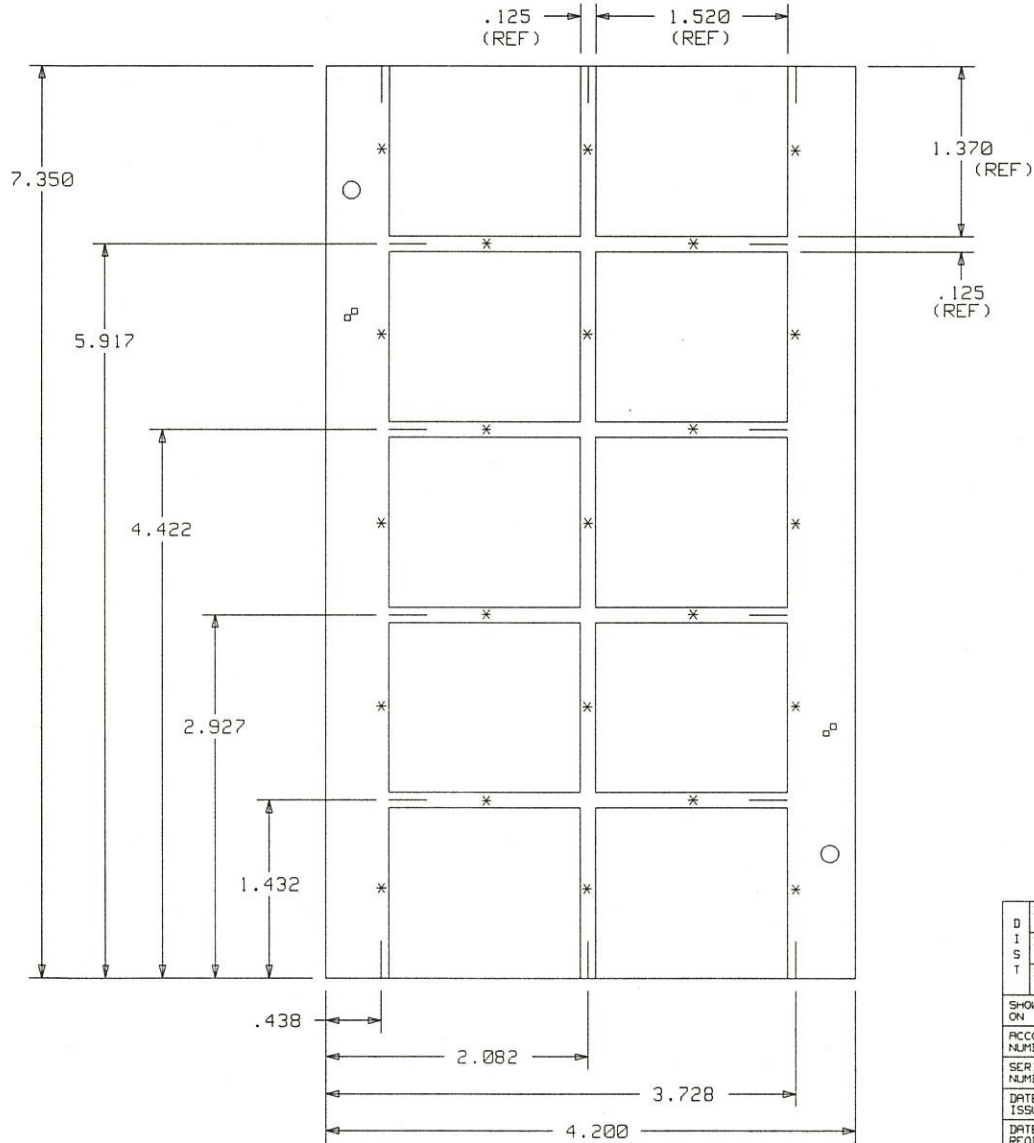


REV.	CHANGES	DRAWN	DATE	CHKD.	DATE

NOTES:

- BOARD MATERIAL: .062 THICK NEMA G10 PER MIL-P-13949G FL-GEN 062C-1/1-A1A (1 OZ. COPPER EACH SIDE).
- PANEL SIZE IS 4.200 +/- .010 X 7.350 +/- .005. SINGLE BOARD SIZE IS 1.520 X 1.370 +/- .005. DIMENSIONS ARE IN INCHES.
- * = APPROXIMATE PLACEMENT OF .050 TABS. SLOTS TO BE .125" WIDE.
- UNSPECIFIED TOLERANCES ARE +/- .005.
- REFERENCE DRAWINGS:
 24A4511 C-1 a000897c1 PARTS LIST (PANEL)
 24A4512 E-1 a000897e1 HOLE SCHEDULE (PANEL)
 24A4512 L-1 a00089711 P.C. BD. ASSY (PANEL)

D I S T		I:		TITLE STAR TPC			
S H O W N		II:		INNER SECTOR ELECTRONICS			
O N		III:		LITTLE ORPHAN ANODE BD (ISOR)-10 WIRES			
ACCT. NO.		DRAWN		BOARD OUTLINE-PANEL OF 10 (24A4511 U-2)			
8052-24		STIRKKINEN		DATE 04/15/94		LAWRENCE BERKELEY LABORATORY	
SERIAL NO.		CHECKED		DATE		UNIVERSITY OF CALIFORNIA	
DATE ISSUED		NO. RECD.		APPROVED		OFFICE OF ELECTRONICS ENGINEERING	
DATE RECD.				ENGINEER JIM HUNTER		FILE NO. a000897m1	SIZE 2
DEL. TO		SCALE NONE		DRAWING NO. 24A4512 M-1			REV.
				E2,R19			SHEET 1 OF 1

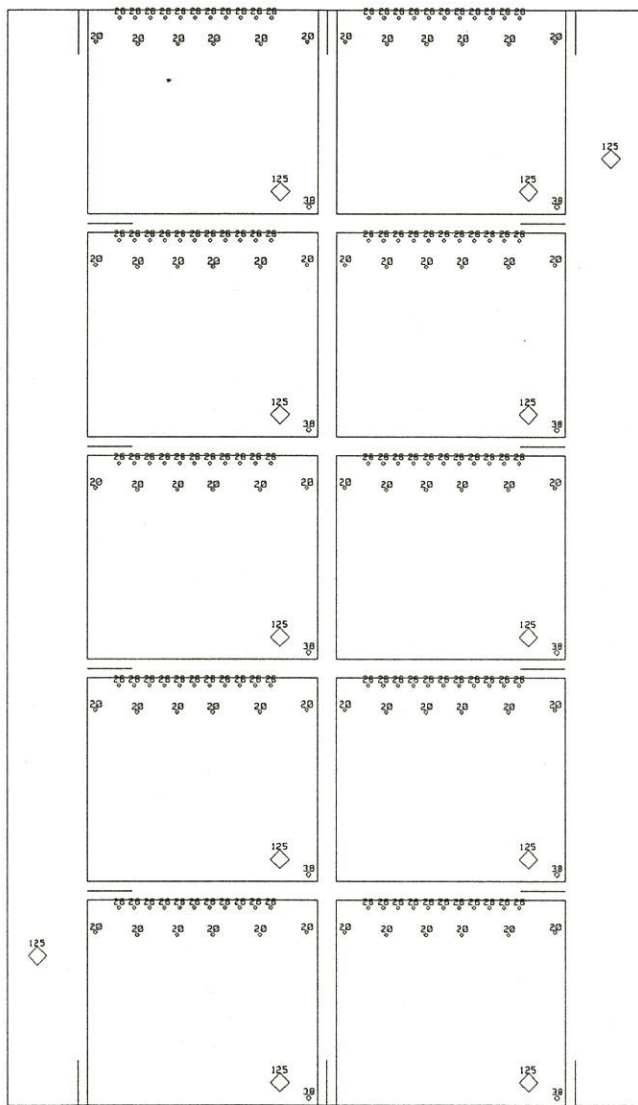

SOLDER SIDE VIEW

REV.	CHANGES	DRAWN	DATE	CHKD.	DATE

NOTES:

- BOARD MATERIAL: .062 THICK NEMA G10 GLASS EPOXY PER MIL-P-13949G FL-GEN 062C-1/1-A1A (1 OZ. COPPER BOTH SIDES).
- SEE HOLE SCHEDULE FOR HOLE SIZES.
- THIS BOARD TO BE THROUGH HOLE PLATED.
- SPECIFIED HOLE DIA. SIZES ARE FOR FINISHED HOLES AFTER PLATING.
- THIS PANEL BOARD IS NOT TO BE SILKSCREENED.
- PANEL SIZE IS 4.200 +/- .010 X 7.350 +/- .005. SINGLE BOARD SIZE IS 1.520 X 1.370 +/- .005. DIMENSIONS ARE IN INCHES. BOARD OUTLINE IS DRAWING 24A4512 M-1 (a000897m1).
- SOLDERMASK IS NOT USED ON THIS BOARD.
- REFERENCE DRAWINGS:
 24A4511 C-1 a000897c1 PARTS LIST (PANEL)
 24A4512 M-1 a000897m1 BOARD OUTLINE (PANEL)
 24A4512 L-1 a000897l1 P.C. BOARD ASSEMBLY (PANEL)


HOLE SCHEDULE		
TOOLING NO.	HOLE DIA.	COUNT
1	.026	110
2	.020	60
3	.038	10
4	.125	12

TOTAL HOLE COUNT = 192.

FOR TOOLING NOS. 1 & 3
 USE .033 DIA. HOLE.
 (COUNT = 120 HOLES)
 USE .016 DIA. HOLE

D I S T	I:	TITLE STAR TPC				
	II:	INNER SECTOR ELECTRONICS				
	III:	LITTLE ORPHAN ANODE BOARD (ISOR)-10 WIRES				
SHOWN ON		HOLE SCHEDULE - PANEL OF 10 (24A4511 U-2)				
ACCOUNT NUMBER	8052-24	DRAWN	DATE	LAWRENCE BERKELEY LABORATORY		
SERIAL NUMBER		STIRKKINEN	04/15/94	UNIVERSITY OF CALIFORNIA		
DATE ISSUED		CHECKED	DATE	OFFICE OF ELECTRONICS ENGINEERING		
DATE RECD.		APPROVED	DATE	FILE NO.	SIZE	
DEL. TO		ENGINEER	JIM HUNTER	a000897e1	2	
		SCALE	NONE	DRAWING NO.	24A4511 E-1	
				REV.		
					C1,E2,E56	
					SHEET 1 OF 1	


REV.	CHANGES	DRAWN	DATE	CHKD.	DATE

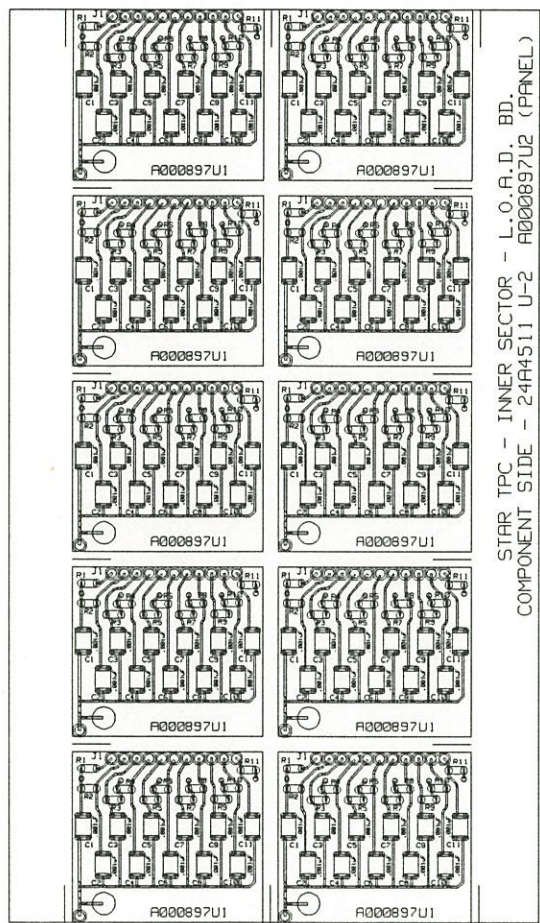

STAR TPC - INNER SECTOR - L.O.A.D. BD.
COMPONENT SIDE - 24A4511 U-2 A000897U2 (PANEL)

11 PIN SOCKET, SAMTEC
#SSK-111-S-G (10 PLACES)

1 PIN SOCKET, SAMTEC
#SSK-101-S-G (10 PLACES)

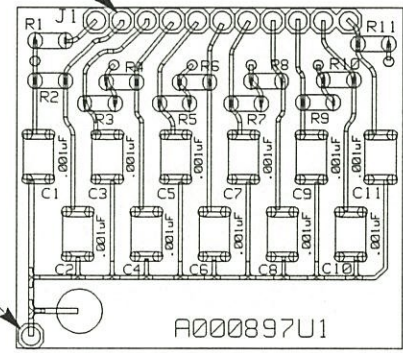

SCALE: ~2:1



NOTES:

- UNLESS OTHERWISE SPECIFIED:
 - A. RESISTORS ARE 10M, 1/8W, 5%, SURFACE MOUNT, SIZE 1206.
 - B. CAPACITORS ARE .001uF, 3KV, CERAMIC, SURFACE MOUNT, SIZE .120" X .180".
- PANEL BOARD SIZE IS 4.200 +/- .010 X 7.350 +/- .005. SINGLE BOARD SIZE IS 1.520 X 1.370 +/- .005. DIMENSIONS ARE IN INCHES. BOARD OUTLINE IS 24A4512 M-1 (a000897m1).
- REFERENCE DRAWINGS:
 - 24A4511 C-1 a000897c1 PARTS LIST (PANEL)
 - 24A4512 M-1 a000897m1 BOARD OUTLINE (PANEL)
 - 24A4512 E-1 a000897e1 HOLE SCHEDULE (PANEL)

DISPATCH	I:	TITLE STAR TPC				
	II:	INNER SECTOR ELECTRONICS				
	III:	LITTLE ORPHAN ANODE BOARD (ISOR)-10 WIRES				
SHOWN ON		P.C. BD. ASSY - PANEL OF 10 (24A4511 U-2)				
ACCOUNT NUMBER	8052-24	DRAWN	DATE	LAWRENCE BERKELEY LABORATORY		
SERIAL NUMBER		CHECKED	DATE	UNIVERSITY OF CALIFORNIA		
DATE ISSUED		APPROVED	DATE	OFFICE OF ELECTRONICS ENGINEERING		
DATE RECD.		ENGINEER	JIM HUNTER	FILE NO.	a00089711	
DEL. TO		SCALE	NONE	SIZE	2	
			E2,E3,E5,E27,E26,E52,E53	DRAWING NO.	24A4512 L-2	
				REV.		
					SHEET 1 OF 1	

REV.	CHANGES	DRAWN	DATE	CHKD.	DATE

LAYER 1 VIEW

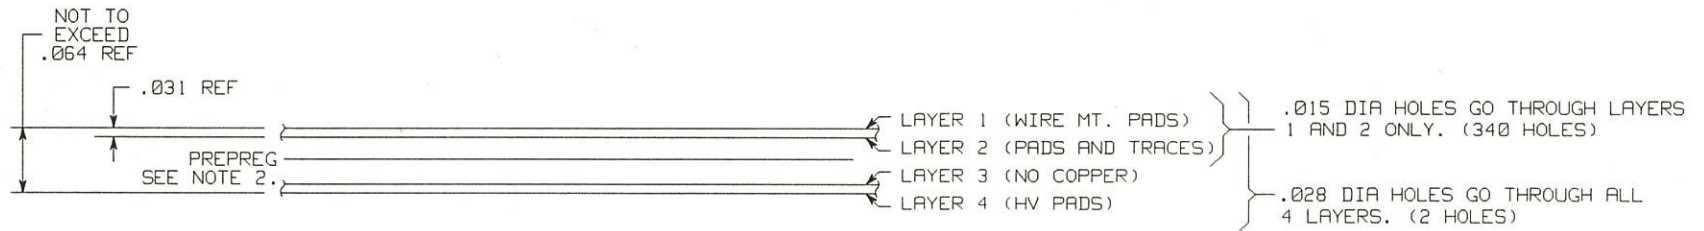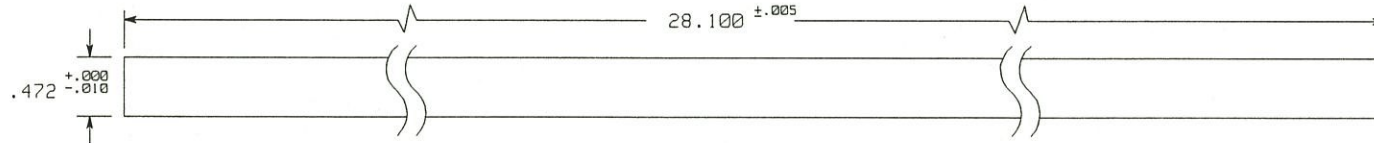


NOTES:

1. BOARD MATERIAL: .031 THICK G10 PER MIL-P-55617 FL-GEN 031C-1/1-A1A (1 OZ. COPPER EACH SIDE). THIS IS A MULTILAYER BOARD (4 LAYERS). TOTAL THICKNESS NOT TO EXCEED .064.
2. PREPREG THICKNESS TO BE DETERMINED BY MANUFACTURER PER IPC-L-109A OR MIL-P-55617.
3. MANUFACTURER MAY NOT PUT ANY IDENTIFICATION NOMENCLATURE ON PRINTED CIRCUIT BOARD.
4. PLEASE NOTE THAT THERE IS NO COPPER ON LAYER 3.
5. DIMENSIONS ARE IN INCHES.
6. BOARD SIZE IS .472 +.000 / -.010 X 28.100 +/- .005.
7. REFERENCE DRAWINGS:

24A4502 E-1	a000896e1	HOLE SCHEDULE - SINGLE BOARD
24A4503 E-2	a000896e2	HOLE SCHEDULE - PANEL OF 16 (BLIND VIAS)
24A4503 E-3	a000896e3	HOLE SCHEDULE - PANEL OF 16
24A4503 M-2	a000896m2	BOARD OUTLINE - PANEL OF 16

D I S T		I:		TITLE STAR TPC	
		II:		INNER SECTOR ELECTRONICS	
		III:		GATED GRID WIRE MOUNT BOARD - SINGLE BD.	
SHOWN ON		BOARD OUTLINE - 24A4501 U-1 (A000896U1)			
ACCOUNT NUMBER	8052-24	DRAWN	STIRKKINEN	DATE	4/08/94
SERIAL NUMBER		CHECKED		DATE	
DATE ISSUED		APPROVED		DATE	
DATE RECD.		ENGINEER	JIM HUNTER	FILE NO.	a000896m1
DEL. TO		SCALE	NONE	SIZE	2
				DRAWING NO.	24A4502 M-1
				REV.	
				SHEET	1 OF 2

REV.	CHANGES	DRAWN	DATE	CHKD.	DATE

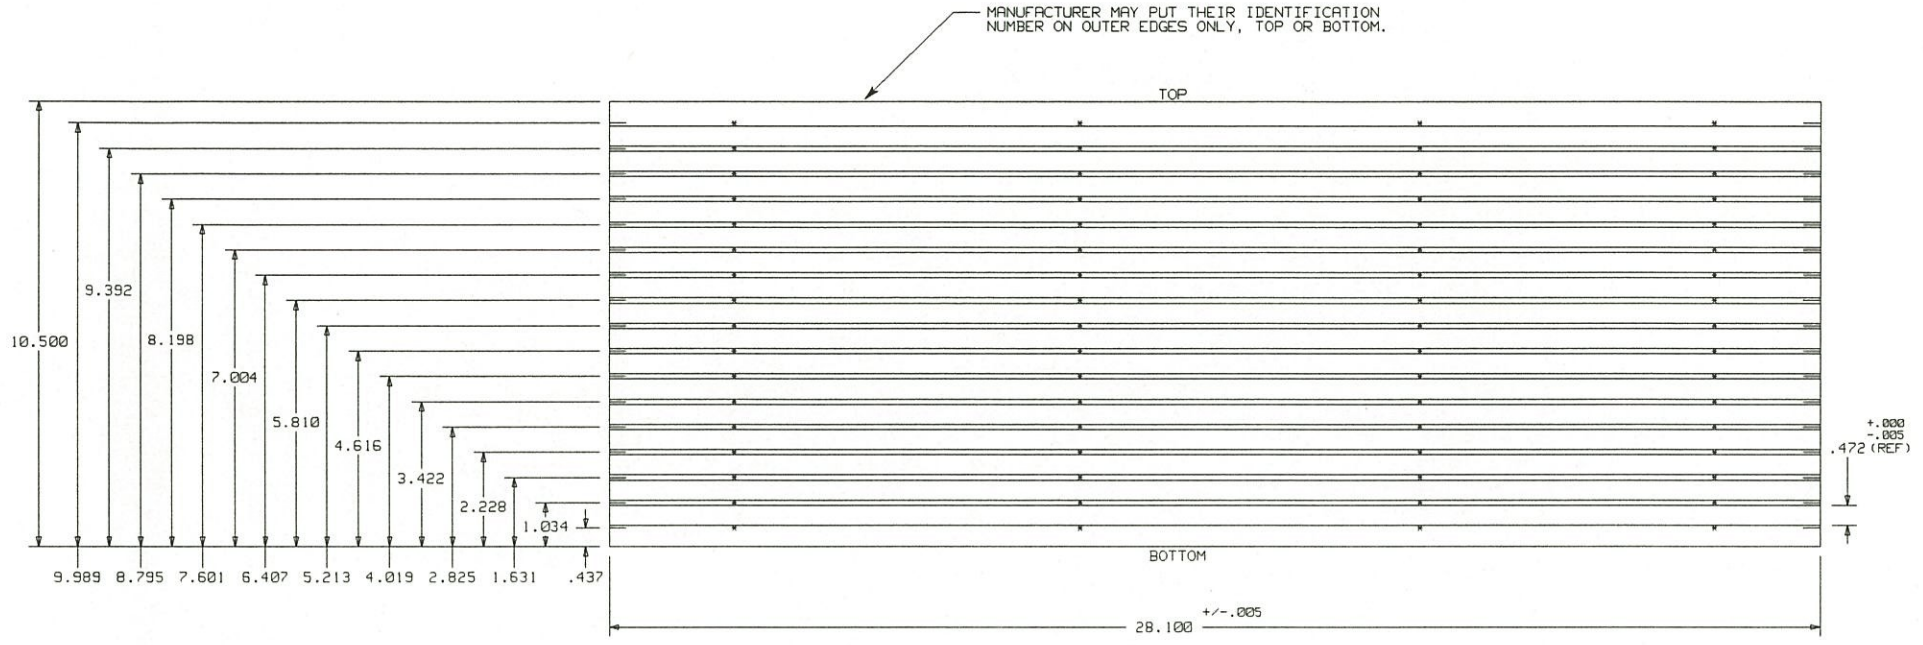

LAYER 1 (WIRE MT. PADS) } SEE DRAWING 24A4503 E-2 FOR DRILLING LAYERS 1 AND 2. (5,440 HOLES)

LAYER 2 (PADS AND TRACES) }

LAYER 3 (NO COPPER) } SEE DRAWING 24A4503 E-3 FOR DRILLING LAYERS 1 THRU 4. (34 HOLES)

LAYER 4 (HV PADS) }

- NOTES:
- BOARD MATERIAL: .031 THICK G10 PER MIL-P-55617 FL-GEN 031C-1/1-A1A (1 OZ. COPPER EACH SIDE). THIS IS A MULTILAYER BOARD (4 LAYERS). TOTAL THICKNESS NOT TO EXCEED .064.
 - PREPREG THICKNESS TO BE DETERMINED BY MANUFACTURER PER IPC-L-109A OR MIL-P-55617.
 - PLEASE NOTE THAT THERE IS NO COPPER ON LAYER 3.
 - BOARD PANEL SIZE IS 10.500 +/- .010 X 28.100 +/- .005. SINGLE BOARD SIZE IS .472 +/- .000/- .010 X 28.100 +/- .005. DIMENSIONS ARE IN INCHES.
 - * = APPROXIMATE PLACEMENT OF .050 TABS. SLOTS TO BE .125 WIDE.
 - REFERENCE DRAWINGS:
 24A4502 E-1 a000896e1 HOLE SCHEDULE - SINGLE BOARD
 24A4503 E-2 a000896e2 HOLE SCHEDULE - PANEL OF 16 (BLIND VIAS)
 24A4503 E-3 a000896e3 HOLE SCHEDULE - PANEL OF 16
 24A4502 M-1 a000896m1 BOARD OUTLINE - SINGLE BOARD

D I S T		TITLE STAR TPC	
S H O W N		INNER SECTOR ELECTRONICS	
R E C O R D		GATED GRID WIRE MOUNT BOARD - PANEL OF 16	
B O A R D		BOARD OUTLINE - 24A4501 U-2 (A000896U2)	
ACCOUNT NUMBER	8052-24	DRAWN	STIRKINEN
SERIAL NUMBER		CHECKED	
DATE ISSUED		DATE	4/08/84
DATE RECD.		APPROVED	
DATE TO		ENGINEER	JIM HUNTER
FILE NO.		SIZE	DRAWING NO.
a000896m2		3	24A4503 M-2
SCALE NONE		SHEET 2 of 2	

PRINT LIST

TITLE: STAR TPC
INNER SECTOR ELECTRONICS
LITTLE ORPHAN ANODE BOARD
(PANEL OF 10 24A4511 U-1,
a000897u1)

FILE NO.: a000897p1 REV: A
PRINT NO.: 24A4511 P-1
CHANGES (*) 09/28/94

ENGINEER: JIM HUNTER
DRAFTER: STIRKKINEN

DATE: 04/15/94
PAGE: 1 OF 1

Drawing No.	Chg. Ltr.	Title
24A4511 C-1 (a000897c1)		PARTS LIST (PANEL)
24A4512 M-1 (a000897m1)		BOARD OUTLINE (PANEL)
24A4512 E-1 (a000897e1)		HOLE SCHEDULE (PANEL)
24A4512 L-1 (a000897l1)	A	PC BOARD ASSEMBLY (PANEL) *
24A4511 U-1 (a000897u1)		PC BOARD - ISOR/10 WIRE (SINGLE BOARD)
24A4511 U-2 (a000897u2)		PC BOARD - ISOR/10 WIRE (PANEL)

** DRAWINGS NOT REQUIRED FOR THIS PACKAGE - SILKSCREEN **

NUMBERS WITHIN () REFER TO EGS COMPUTER FILES

* PRINT LIST

TITLE: STAR TPC
INNER SECTOR ELECTRONICS
GATED GRID WIRE MOUNT BOARD
(PANEL OF 16 BOARDS)

FILE NO.: a000896p1 REV:
PRINT NO.: 24A4501 P-1
CHANGES (*)

ENGINEER: JIM HUNTER
DRAFTER: STIRKKINEN

DATE: 04/08/94
PAGE: 1 OF 1



Drawing No.	Chg. Ltr.	Title
24A4502 M-1 (a000896m1)		BOARD OUTLINE - SINGLE BOARD
24A4503 M-2 (a000896m2)		BOARD OUTLINE - PANEL OF 16
24A4502 E-1 (a000896e1)		HOLE SCHEDULE - SINGLE BOARD
24A4503 E-2 (a000896e2)		HOLE SCHEDULE - PANEL OF 16 (BLIND VIAS)
24A4503 E-3 (a000896e3)		HOLE SCHEDULE - PANEL OF 16
24A4501 U-1 (a000896u1)		ARTWORK - SINGLE BOARD LAYER 1 - WIRE MOUNT PADS LAYER 2 - PADS AND TRACES LAYER 3 - NO COPPER (BLANK) LAYER 4 - H.V. PADS
24A4501 U-2 (a000896u2)		ARTWORK - PANEL OF 16 24A4501 U-1'S

** THE FOLLOWING DRAWINGS NOT REQUIRED FOR THIS PACKAGE:
PARTS LIST, SILKSCREEN, PC BOARD ASSEMBLY

NUMBERS WITHIN () REFER TO EGS COMPUTER FILES

REV.	CHANGES	DRAWN	DATE	CHKD.	DATE

LAYER 1 VIEW

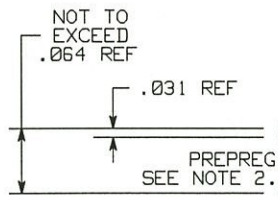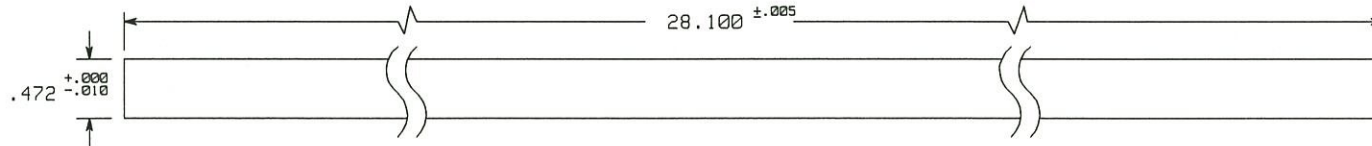

LAYER 1 (WIRE MT. PADS)
 LAYER 2 (PADS AND TRACES)
 LAYER 3 (NO COPPER)
 LAYER 4 (HV PADS)



.015 DIA HOLES GO THROUGH LAYERS 1 AND 2 ONLY. (340 HOLES)
 .028 DIA HOLES GO THROUGH ALL 4 LAYERS. (2 HOLES)

NOTES:

- BOARD MATERIAL: .031 THICK G10 PER MIL-P-55617 FL-GEN 031C-1/1-A1A (1 OZ. COPPER EACH SIDE). THIS IS A MULTILAYER BOARD (4 LAYERS). TOTAL THICKNESS NOT TO EXCEED .064.
- PREPREG THICKNESS TO BE DETERMINED BY MANUFACTURER PER IPC-L-109A OR MIL-P-55617.
- MANUFACTURER MAY NOT PUT ANY IDENTIFICATION NOMENCLATURE ON PRINTED CIRCUIT BOARD.
- PLEASE NOTE THAT THERE IS NO COPPER ON LAYER 3.
- DIMENSIONS ARE IN INCHES.
- BOARD SIZE IS .472 +.000 / -.010 X 28.100 +/- .005.
- REFERENCE DRAWINGS:
 24A4502 E-1 a000896e1 HOLE SCHEDULE - SINGLE BOARD
 24A4503 E-2 a000896e2 HOLE SCHEDULE - PANEL OF 16 (BLIND VIAS)
 24A4503 E-3 a000896e3 HOLE SCHEDULE - PANEL OF 16
 24A4503 M-2 a000896m2 BOARD OUTLINE - PANEL OF 16

D I S T		I:		TITLE STAR TPC			
SHOWN ON		II:		INNER SECTOR ELECTRONICS			
ACCOUNT NUMBER		III:		GATED GRID WIRE MOUNT BOARD - SINGLE BD.			
SERIAL NUMBER		DATE		BOARD OUTLINE - 24A4501 U-1 (A000896U1)			
DATE ISSUED		NO. RECD.		DRAWN		DATE	
DATE RECD.		APPROVED		STIRKKINEN		4/08/94	
DEL. TO		ENGINEER		LAWRENCE BERKELEY LABORATORY			
SCALE		JIM HUNTER		UNIVERSITY OF CALIFORNIA			
NONE		a000896m1		OFFICE OF ELECTRONICS ENGINEERING			
E2		2		FILE NO.		SIZE	
				a000896m1		2	
				DRAWING NO.		REV.	
				24A4502 M-1			
				SHEET 1 OF 2			

REV.	CHANGES	DRAWN	DATE	CHKD.	DATE

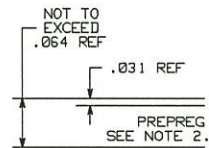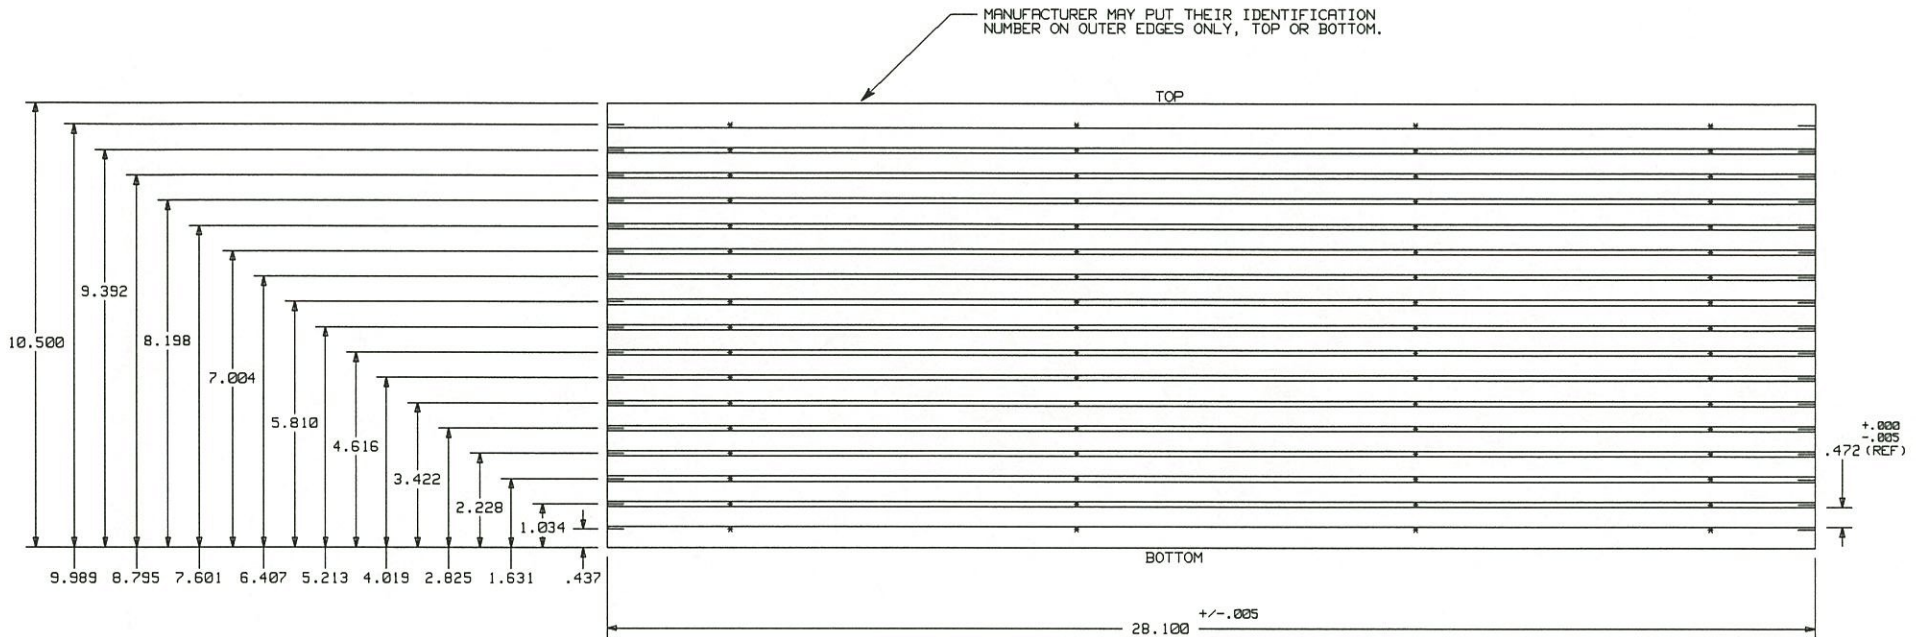

SEE DRAWING 24A4503 E-2 FOR DRILLING LAYERS 1 AND 2. (5,440 HOLES)

SEE DRAWING 24A4503 E-3 FOR DRILLING LAYERS 1 THRU 4. (34 HOLES)


NOTES:

- BOARD MATERIAL: .031 THICK G10 PER MIL-P-55617 FL-GEN 031C-1/1-A1A (1 OZ. COPPER EACH SIDE). THIS IS A MULTILAYER BOARD (4 LAYERS). TOTAL THICKNESS NOT TO EXCEED .064.
- PREPREG THICKNESS TO BE DETERMINED BY MANUFACTURER PER IPC-L-109A OR MIL-P-55617.
- PLEASE NOTE THAT THERE IS NO COPPER ON LAYER 3.
- BOARD PANEL SIZE IS 10.500 +/- .010 X 28.100 +/- .005. SINGLE BOARD SIZE IS .472 +/- .000/- .010 X 28.100 +/- .005. DIMENSIONS ARE IN INCHES.
- * = APPROXIMATE PLACEMENT OF .050 TABS. SLOTS TO BE .125 WIDE.
- REFERENCE DRAWINGS:
 24A4502 E-1 a000896e1 HOLE SCHEDULE - SINGLE BOARD
 24A4503 E-2 a000896e2 HOLE SCHEDULE - PANEL OF 16 (BLIND VIAS)
 24A4503 E-3 a000896e3 HOLE SCHEDULE - PANEL OF 16
 24A4502 M-1 a000896m1 BOARD OUTLINE - SINGLE BOARD

D I:		TITLE STAR TPC			
I I:		INNER SECTOR ELECTRONICS			
T III:		GATED GRID WIRE MOUNT BOARD - PANEL OF 16			
SHOW ON:		BOARD OUTLINE - 24A4501 U-2 (A000896U2)			
ACCOUNT NUMBER	8052-24	DRAWN	DATE	LAWRENCE BERKELEY LABORATORY	
SERIAL NUMBER		CHECKED	DATE	UNIVERSITY OF CALIFORNIA	
DATE ISSUED		APPROVED	DATE	OFFICE OF ELECTRONICS ENGINEERING	
DATE RECD.		ENGINEER	JIM HUNTER	FILE NO.	a000896m2
DEL. TO		SCALE	NONE	SIZE	3
				DRAWING NO.	24A4503 M-2
				REV.	
					SHEET 2 OF 2

REV.	CHANGES	DRAWN	DATE	CHKD.	DATE

LAYER ONE VIEW

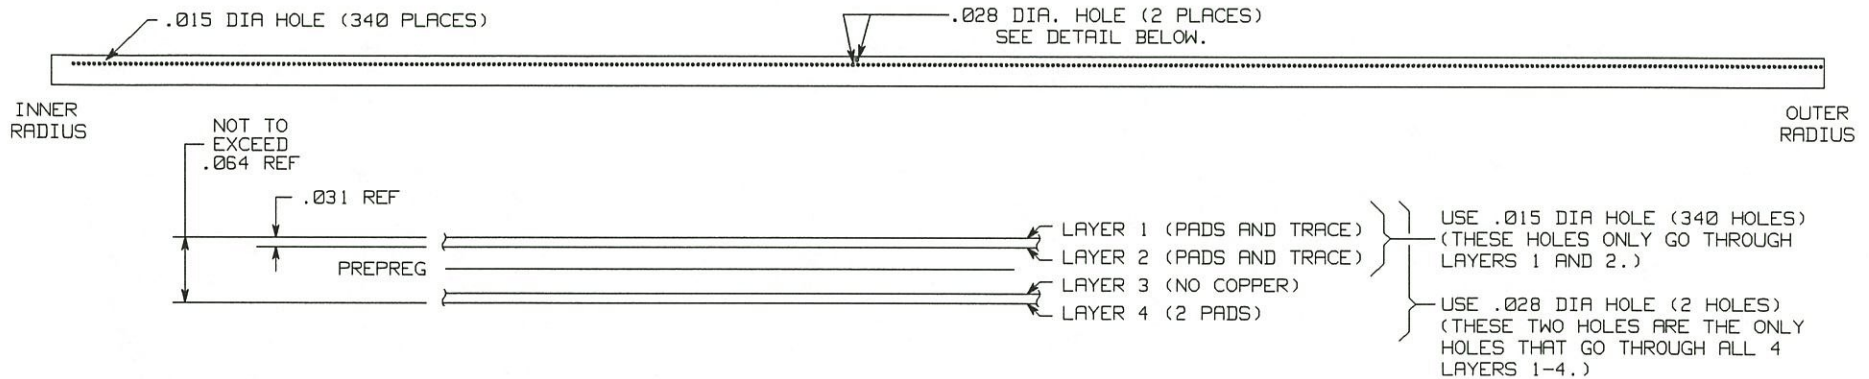

NOTES:


- BOARD MATERIAL: .031 THICK G10 PER MIL-P-55617 FL-GEN 031C-1/1-A1A (1 OZ. COPPER EACH SIDE). THIS IS A MULTILAYER BOARD (4 LAYERS). TOTAL THICKNESS NOT TO EXCEED .064.
- MANUFACTURER MAY NOT PUT ANY IDENTIFICATION NOMENCLATURE ON PRINTED CIRCUIT BOARD.
- PLEASE NOTE THAT THERE IS NO COPPER ON LAYER 3.
- THIS BOARD TO BE THROUGH HOLE PLATED. SEE DETAIL FOR BLIND VIAS (340 HOLES).
- SPECIFIED HOLE DIA. SIZES ARE FOR FINISHED HOLES AFTER PLATING.
- BOARD SIZE IS .472 +.000/-.010 X 28.100 +/- .005. DIMENSIONS ARE IN INCHES. BOARD OUTLINE DRAWING IS 24A4502 M-1 (a000896m1).
- SOLDERMASK IS NOT USED ON THIS BOARD.
- REFERENCE DRAWINGS:
 - 24A4502 M-1 a000896m1 BOARD OUTLINE - SINGLE BOARD
 - 24A4503 M-2 a000896m2 BOARD OUTLINE - PANEL OF 16
 - 24A4503 E-2 a000896e2 HOLE SCHEDULE - PANEL OF 16 (BLIND VIAS)
 - 24A4503 E-3 a000896e3 HOLE SCHEDULE - PANEL OF 16

D I S T		I:		TITLE		STAR TPC	
		II:				INNER SECTOR ELECTRONICS	
		III:				GATED GRID WIRE MOUNT BOARD - SINGLE BD.	
SHOWN ON						HOLE SCHEDULE - 24A4501 U-1 (A000896U1)	
ACCOUNT NUMBER	8052-24	DRAWN	STIRKKINEN	DATE	4/8/94	LAWRENCE BERKELEY LABORATORY	
SERIAL NUMBER		CHECKED		DATE		UNIVERSITY OF CALIFORNIA	
DATE ISSUED	NO. RECD.	APPROVED		DATE		OFFICE OF ELECTRONICS ENGINEERING	
DATE RECD.		ENGINEER	JIM HUNTER	FILE NO.	a000896e1	SIZE	2
DEL. TO		SCALE	NONE		E2, C3	DRAWING NO.	24A4502 E-1
						REV.	
						SHEET 1 OF 3	

LAYER TWO VIEW

SCALE: NONE

TOP

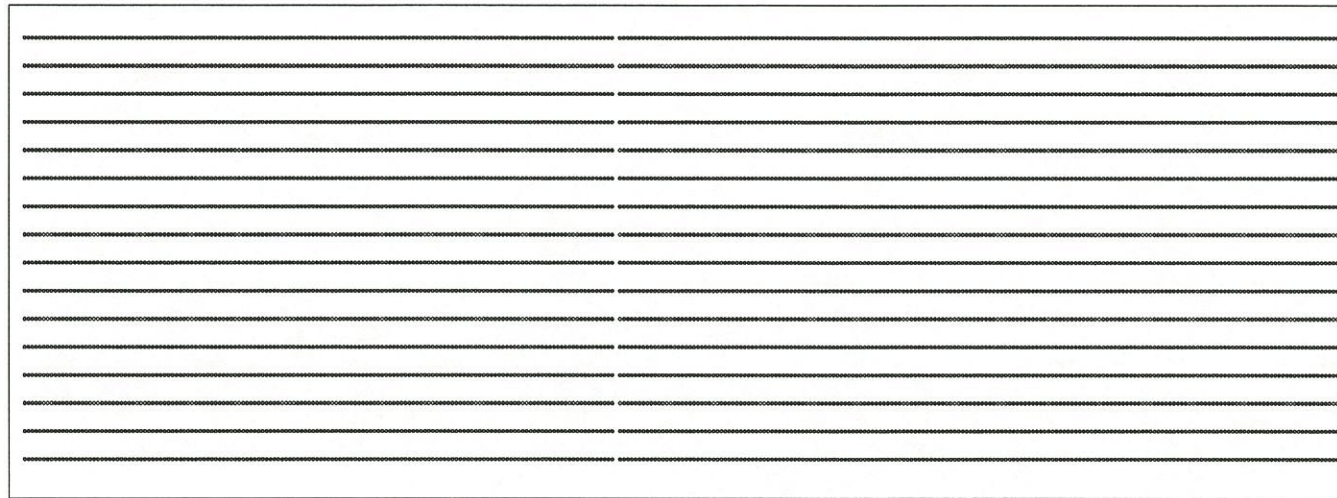


BOTTOM

INNER RADIUS

MANUFACTURER MAY PUT THEIR IDENTIFICATION NUMBER ON OUTER EDGES ONLY, TOP OR BOTTOM.

OUTER RADIUS

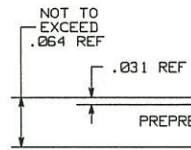

USE .015 DIA HOLE (5,440 HOLES)
THESE HOLES ONLY GO THROUGH
LAYERS 1 AND 2 (BLIND VIAS).
SEE THIS DRAWING.

USE .020 DIA HOLE (32 HOLES).
DRILL THESE HOLES AFTER ASSEMBLY
OF ALL LAYERS, SEE DRAWING
24A4503 E-3.

NOTES:

- BOARD MATERIAL: .031 THICK G10 PER MIL-P-55617 FL-GEN 031C-1/1-A1A (1 OZ. COPPER EACH SIDE). THIS IS A MULTILAYER BOARD (4 LAYERS). TOTAL THICKNESS NOT TO EXCEED .064.
- PLEASE NOTE THAT THERE IS NO COPPER ON LAYER 3.
- THIS BOARD TO BE THROUGH HOLE PLATED.
- SPECIFIED HOLE DIA. SIZES ARE FOR FINISHED HOLES AFTER PLATING.
- BOARD SIZE IS 10.500 +/- .010 X 28.100 +/- .005. DIMENSIONS ARE IN INCHES. BOARD OUTLINE DRAWING IS 24A4503 M-2 (a000896m2).
- SOLDERMASK IS NOT USED ON THIS BOARD.
- REFERENCE DRAWINGS:

24A4502 M-1	a000896m1	BOARD OUTLINE - SINGLE BOARD
24A4503 M-2	a000896m2	BOARD OUTLINE - PANEL OF 16
24A4502 E-1	a000896e1	HOLE SCHEDULE - SINGLE BOARD
24A4503 E-3	a000896e3	HOLE SCHEDULE - PANEL OF 16



HOLE SCHEDULE		
CODE	HOLE DIA.	COUNT
NONE	.015	5,440

D I S T		TITLE STAR TPC	
I:		INNER SECTOR ELECTRONICS	
II:		GATED GRID WIRE MOUNT BOARD - PANEL 0F 16	
III:		HOLE SCHEDULE - 24A4501 U-2 (BLIND VIAS)	
SHOWN ON		LAWRENCE BERKELEY LABORATORY	
ACCOUNT NUMBER 8052-24	DRAWN STIRAKLINEN	DATE 4/08/94	UNIVERSITY OF CALIFORNIA
SERIAL NUMBER	CHECKED	DATE	OFFICE OF ELECTRONICS ENGINEERING
DATE ISSUED	NO. REGD.	APPROVED	FILE NO.
DATE RECD.		JIM HUNTER	a000896e2
DEL. TO	SCALE NONE	SIZE 3	DRAWING NO. 24A4503 E-2
			REV. CB,E14

REV.	CHANGES	DRAWN	DATE	CHKD.	DATE
------	---------	-------	------	-------	------

LAYER FOUR VIEW

SCALE: NONE

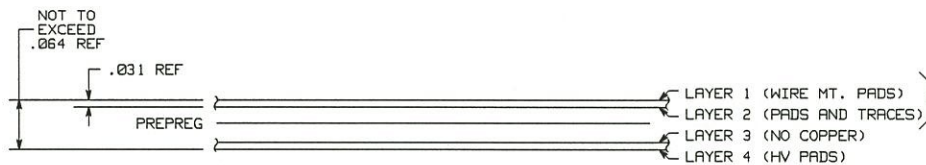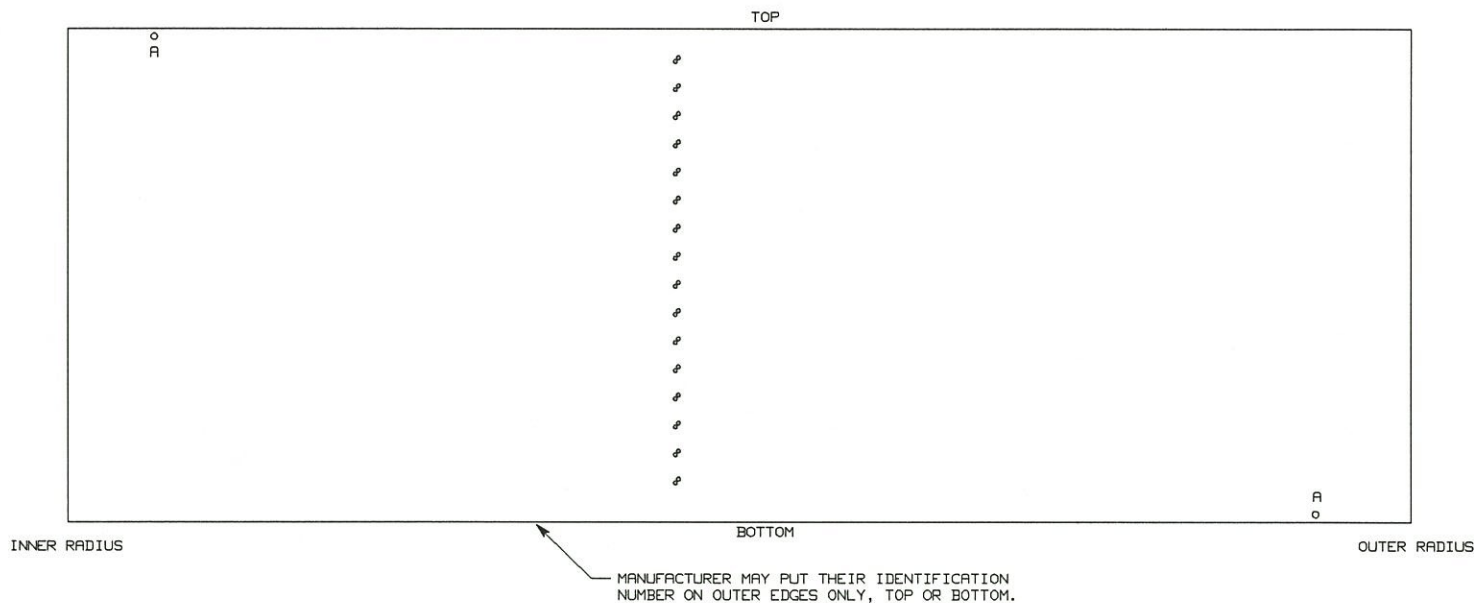

USE .015 DIA HOLE (5,440 HOLES)
THESE HOLES ONLY GO THROUGH
LAYERS 1 AND 2 (BLIND VIAS).
SEE DRAWING 24A4503 E-2.

USE .028 DIA HOLE (32 HOLES).
DRILL THESE HOLES AFTER ASSEMBLY
OF ALL LAYERS, SEE THIS DRAWING.

NOTES:

- BOARD MATERIAL: .031 THICK G10 PER MIL-P-55617 FL-GEN 031C-1/1-A1A (1 OZ. COPPER EACH SIDE). THIS IS A MULTILAYER BOARD (4 LAYERS). TOTAL THICKNESS NOT TO EXCEED .064.
- PLEASE NOTE THAT THERE IS NO COPPER ON LAYER 3.
- THIS BOARD TO BE THROUGH HOLE PLATED.
- SPECIFIED HOLE DIA. SIZES ARE FOR FINISHED HOLES AFTER PLATING.
- BOARD SIZE IS 10.500 +/- .010 X 28.100 +/- .005. DIMENSIONS ARE IN INCHES. BOARD OUTLINE DRAWING IS 24A4503 M-2 (a000896m2).
- SOLDERMASK IS NOT USED ON THIS BOARD.
- REFERENCE DRAWINGS:

24A4502 M-1	a000896m1	BOARD OUTLINE - SINGLE BOARD
24A4503 M-2	a000896m2	BOARD OUTLINE - PANEL OF 16
24A4502 E-1	a000896e1	HOLE SCHEDULE - SINGLE BOARD
24A4503 E-2	a000896e2	HOLE SCHEDULE - PANEL OF 16, BLIND VIAS

HOLE SCHEDULE		
CODE	HOLE DIA.	COUNT
NONE	.028	32
A	.125	2

I:		TITLE STAR TPC	
II:		INNER SECTOR ELECTRONICS	
III:		GATED GRID WIRE MOUNT BOARD - PANEL OF 16	
SHOW ON:		HOLE SCHEDULE - 24A4501 U-2 (A000896U2)	
ACCOUNT NUMBER	8052-24	DRAWN	DATE
SERIAL NUMBER		STIRAKKINEN	4/08/84
DATE ISSUED		CHECKED	DATE
DATE RECD.		APPROVED	DATE
DEL. TO		ENGINEER	JIM HUNTER
		FILE NO.	a000896e3
		SIZE	3
		DRAWING NO.	24A4503 E-3
		REV.	
		SCALE	NONE
			E14
			SHEET 3 of 3

PRINT LIST

TITLE: STAR PROJECT
SECTOR ELECTRONICS
GATED GRID CONNECTION BOARD
(PANEL OF 68 - 24A4521 U-1,
a000898u1)

FILE NO.: a000898p1 REV:
PRINT NO.: 24A4521 P-1
CHANGES (*)

ENGINEER: HOWARD WIEMAN
DRAFTER: STIRKKINEN


DATE: 09/28/94
PAGE: 1 OF 1

Drawing No.	Chg. Ltr.	Title
24A4524 M-1 (a000898m1)		BOARD OUTLINE (PANEL)
24A4523 E-1 (a000898e1)		HOLE SCHEDULE (PANEL)
24A4521 L-1 (a000898l1)		PC BOARD ASSEMBLY (SINGLE)
24A4521 U-1 (a000898u1)		PC BOARD (SINGLE BOARD)
24A4521 U-2 (a000898u2)		PC BOARD (PANEL OF 68 24A4521 U-1)

** DRAWINGS NOT REQUIRED FOR THIS PACKAGE - SILKSCREEN
OR PARTS LIST **

NUMBERS WITHIN () REFER TO EGS COMPUTER FILES

REV.	CHANGES	DRAWN	DATE	CHKD.	DATE

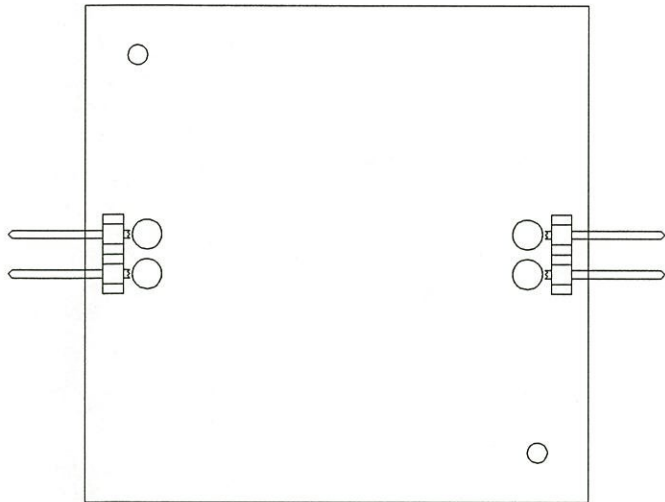

COMPONENT SIDE

NOTES:

- CONNECTORS ARE 2 PINS, RIGHT ANGLE, SAMTEC # HMTSW-150-08-S-S-230-RA. (2 PLACES)
- BOARD SIZE IS 1.250 X 1.250 +/- .010. DIMENSIONS ARE IN INCHES.
- REFERENCE DRAWINGS:

24A4523 E-1	a000898e1	HOLE SCHEDULE -
		PANEL OF 68
24A4524 M-1	a000898m1	BOARD OUTLINE -
		PANEL OF 68

D I S T	I:	TITLE STAR TPC					
	II:	SECTORS ELECTRONICS					
	III:	GATED GRID CONNECTION BOARD					
SHOWN ON		PC BOARD ASSEMBLY-SINGLE BD.(24A4521 U-1)					
ACCOUNT NUMBER 8052-24		DRAWN STIRKKINEN	DATE 08/03/94	LAWRENCE BERKELEY LABORATORY UNIVERSITY OF CALIFORNIA OFFICE OF ELECTRONICS ENGINEERING			
SERIAL NUMBER		CHECKED	DATE				
DATE ISSUED	NO. REQD.	APPROVED	DATE				
DATE REQD.		ENGINEER		FILE NO. a00089811	SIZE 1	DRAWING NO. 24A4521 L-1	REV.
DEL. TO		SCALE ~2:1	E2, E3, E26			SHEET 1 OF 1	

PRINT LIST

TITLE: STAR TPC
INNER SECTOR ELECTRONICS
SHIELD GRID WIRE MOUNT BOARD
(PANEL OF 16 BOARDS)

FILE NO.: a000893p1 REV:
PRINT NO.: 24A3661 P-1
CHANGES (*)

ENGINEER: JIM HUNTER
DRAFTER: STIRKKINEN

DATE: 04/01/94
PAGE: 1 OF 1

Drawing No.	Chg. Ltr.	Title
24A3662 M-1 (a000893m1)		BOARD OUTLINE - SINGLE BOARD
24A3663 M-2 (a000893m2)		BOARD OUTLINE - PANEL OF 16
24A3662 E-1 (a000893e1)		HOLE SCHEDULE - SINGLE BOARD
24A3663 E-2 (a000893e2)		HOLE SCHEDULE - PANEL OF 16
24A3661 U-1 (a000893u1)		ARTWORK - SINGLE BOARD
24A3661 U-2 (a000893u2)		ARTWORK - PANEL OF 16 24A3661 U-1'S

** THE FOLLOWING DRAWINGS NOT REQUIRED FOR THIS PACKAGE:
PARTS LIST, SILKSCREEN, PC BOARD ASSEMBLY

NUMBERS WITHIN () REFER TO EGS COMPUTER FILES

PRINT LIST

TITLE: STAR TPC
 INNER SECTOR ELECTRONICS
 ANODE WIRE MOUNT BOARD
 (PANEL OF SIX BOARDS)

FILE NO.: a000892p1 REV: A
 PRINT NO.: 24A3651 P-1
 CHANGES (*) 09/28/94

ENGINEER: JIM HUNTER
 DRAFTER: STIRKKINEN

DATE: 04/14/94
 PAGE: 1 OF 1

Drawing No.	Chg. Ltr.	Title
24A3651 C-1 (a000892c1)		PARTS LIST (PANEL)
24A3654 M-1 (a000892m1)		BOARD OUTLINE - CUTOUTS (PANEL)
24A3654 M-2 (a000892m2)		BOARD OUTLINE (PANEL)
24A3654 E-1 (a000892e1)		HOLE SCHEDULE - BLIND VIAS
24A3654 E-2 (a000892e2)	A	HOLE SCHEDULE - LAYERS 1 THRU 4 *
24A3654 L-1 (a000892l1)		P.C. BOARD ASSEMBLY (PANEL)
24A3651 U-1 (a000892u1)		ARTWORK - SINGLE BOARD LAYER 1 - GROUND PLANE LAYER 2 - PADS LAYER 3 - H.V. CIRCUIT LAYER 4 - OUTER TRACE LAYER
24A3651 U-2 (a000892u2)		ARTWORK - PANEL OF SIX 24A3651 U-1'S

** THE FOLLOWING DRAWING NOT REQUIRED FOR THIS PACKAGE:
 SILKSCREEN

NUMBERS WITHIN () REFER TO EGS COMPUTER FILES

*

PARTS LIST

TITLE: STAR TPC
INNER SECTOR ELECTRONICS
ANODE WIRE MOUNT BOARD
(PANEL OF 6)

FILE NO.: a000892c1 REV:
PRINT NO.: 24A3651 C-1
CHANGES (*)

ENGINEER: JIM HUNTER
DRAFTER: STIRKKINEN

DATE: 04/14/94
PAGE: 1 OF 1

Reference	Stock No.	Part Type	Description	Qty
HARDWARE				
-	NS	BBL-111-G-E	11 PIN SOCKET, STRAIGHT, SAMTEC #BBL-111-G-E	6
-	NS	BBL-121-G-E	21 PIN SOCKET, STRAIGHT, SAMTEC #BBL-121-G-E	96
-	NS	BBL-101-G-E	1 PIN SOCKET, STRAIGHT, SAMTEC #BBL-101-G-E	6
-	NS	104716-1	1 PIN CONNECTOR, RIGHT ANGLE, AMP #104716-1 OR SAMTEC #HMTSW-1-1-08-S- S230-RA	24
-	NS	a000892u2	24A3651 U-2, PRINTED CIRCUIT BOARD (PANEL OF 6 24A3651 U-1, a000892u1)	1

APRIL 24, 1995

HI WOODY:

HERE ARE THE DRILL FILES FOR JOB A000892U2. I DECIDED TO CREATE BOTH OF THEM. (PANEL OF 6 BOARDS)

DRILL FILE PL892B - BLIND VIAS

TOOLING NO.	DIA. SIZE	COUNT
1	.020	1020

DRILL FILE PL892T - THRU VIAS

TOOLING NO.	DIA. SIZE	COUNT
1	.125	92
2	.026	2088
3	.038	1032
4	.250	108

TOTAL HOLE COUNT = 3320.

HERE ARE THE DRILL FILES FOR JOB A000896U2 (PANEL OF 16 BOARDS).

DRILL FILE PL896B - BLIND VIAS

TOOLING NO.	DIA. SIZE	COUNT
1	.015	5440

DRILL FILE PL896T - THRU VIAS

TOOLING NO.	DIA. SIZE	COUNT
1	.125	2
2	.028	32

TOTAL HOLE COUNT = 34.

IF YOU HAVE ANY QUESTIONS OR PROBLEMS PLEASE CALL ME (JUDY) AT (916)547-4005. SORRY FOR THE DELAY. HAVE A GOOD WEEK!

APRIL 24, 1995

HI WOODY:

HERE ARE THE DRILL FILES FOR JOB A000892U2. I DECIDED TO CREATE BOTH OF THEM. (PANEL OF 6 BOARDS)

DRILL FILE PL892D1 - BLIND VIAS

TOOLING NO.	DIA. SIZE	COUNT
1	.020	1020

DRILL FILE PL892D2 - THRU VIAS

TOOLING NO.	DIA. SIZE	COUNT
1	.125	92
2	.026	2088
3	.038	1032
4	.250	108

TOTAL HOLE COUNT = 3320.

HERE ARE THE DRILL FILES FOR JOB A000896U2 (PANEL OF 16 BOARDS).

DRILL FILE PL896D1 - BLIND VIAS

TOOLING NO.	DIA. SIZE	COUNT
1	.015	5440

DRILL FILE PL896D2 - THRU VIAS

TOOLING NO.	DIA. SIZE	COUNT
1	.125	2
2	.028	32

TOTAL HOLE COUNT = 34.

IF YOU HAVE ANY QUESTIONS OR PROBLEMS PLEASE CALL ME (JUDY) AT (916)547-4005. SORRY FOR THE DELAY. HAVE A GOOD WEEK!

ORIGIN: -300, 3500
-350, 18400

STAR-INNER-ANODE WIRE MT. BD.
a000892u1 (a000892a2)
28.100 x 18.300

3/29/94
4/11/94

LAYER 1 =

GND PLANE \Rightarrow #E24 #C19 \Rightarrow a892g1-g
v CMD892L1G = A892L1G = PL892L1C (5/16/94)

CIRCUIT \Rightarrow #E3 #C19 #E11 #E55 = a892ll-g
v CMD892L1C = A892L1C = PL892L1G (5/16/94)


LAYER 2 \Rightarrow PADS ONLY \Rightarrow #E3 #E19 #E12 #E55 = a892L2-g
CMD892L2 = A892L2 = PL892L2 (5/16/94)

LAYER 3 \Rightarrow #E3 #E5 #E19 #E55 = a892L3-g
CMD892L3 = A892L3 = PL892L3 (5/16/94)

LAYER 4 \Rightarrow #E3 #E6 #E19 #E55 = a892L4-g
CMD892L4 = A892L4 = PL892L4 (5/16/94)

DRILL INFO (LAYERS #3 & #4) \Rightarrow #C23 #E56 = a892dr1-g
CMD892DR1 = PL892DR1

DRILL INFO (ALL LAYERS) \Rightarrow #C1 #E56 = a892dr2-g
CMD892DR2 = PL892DR2

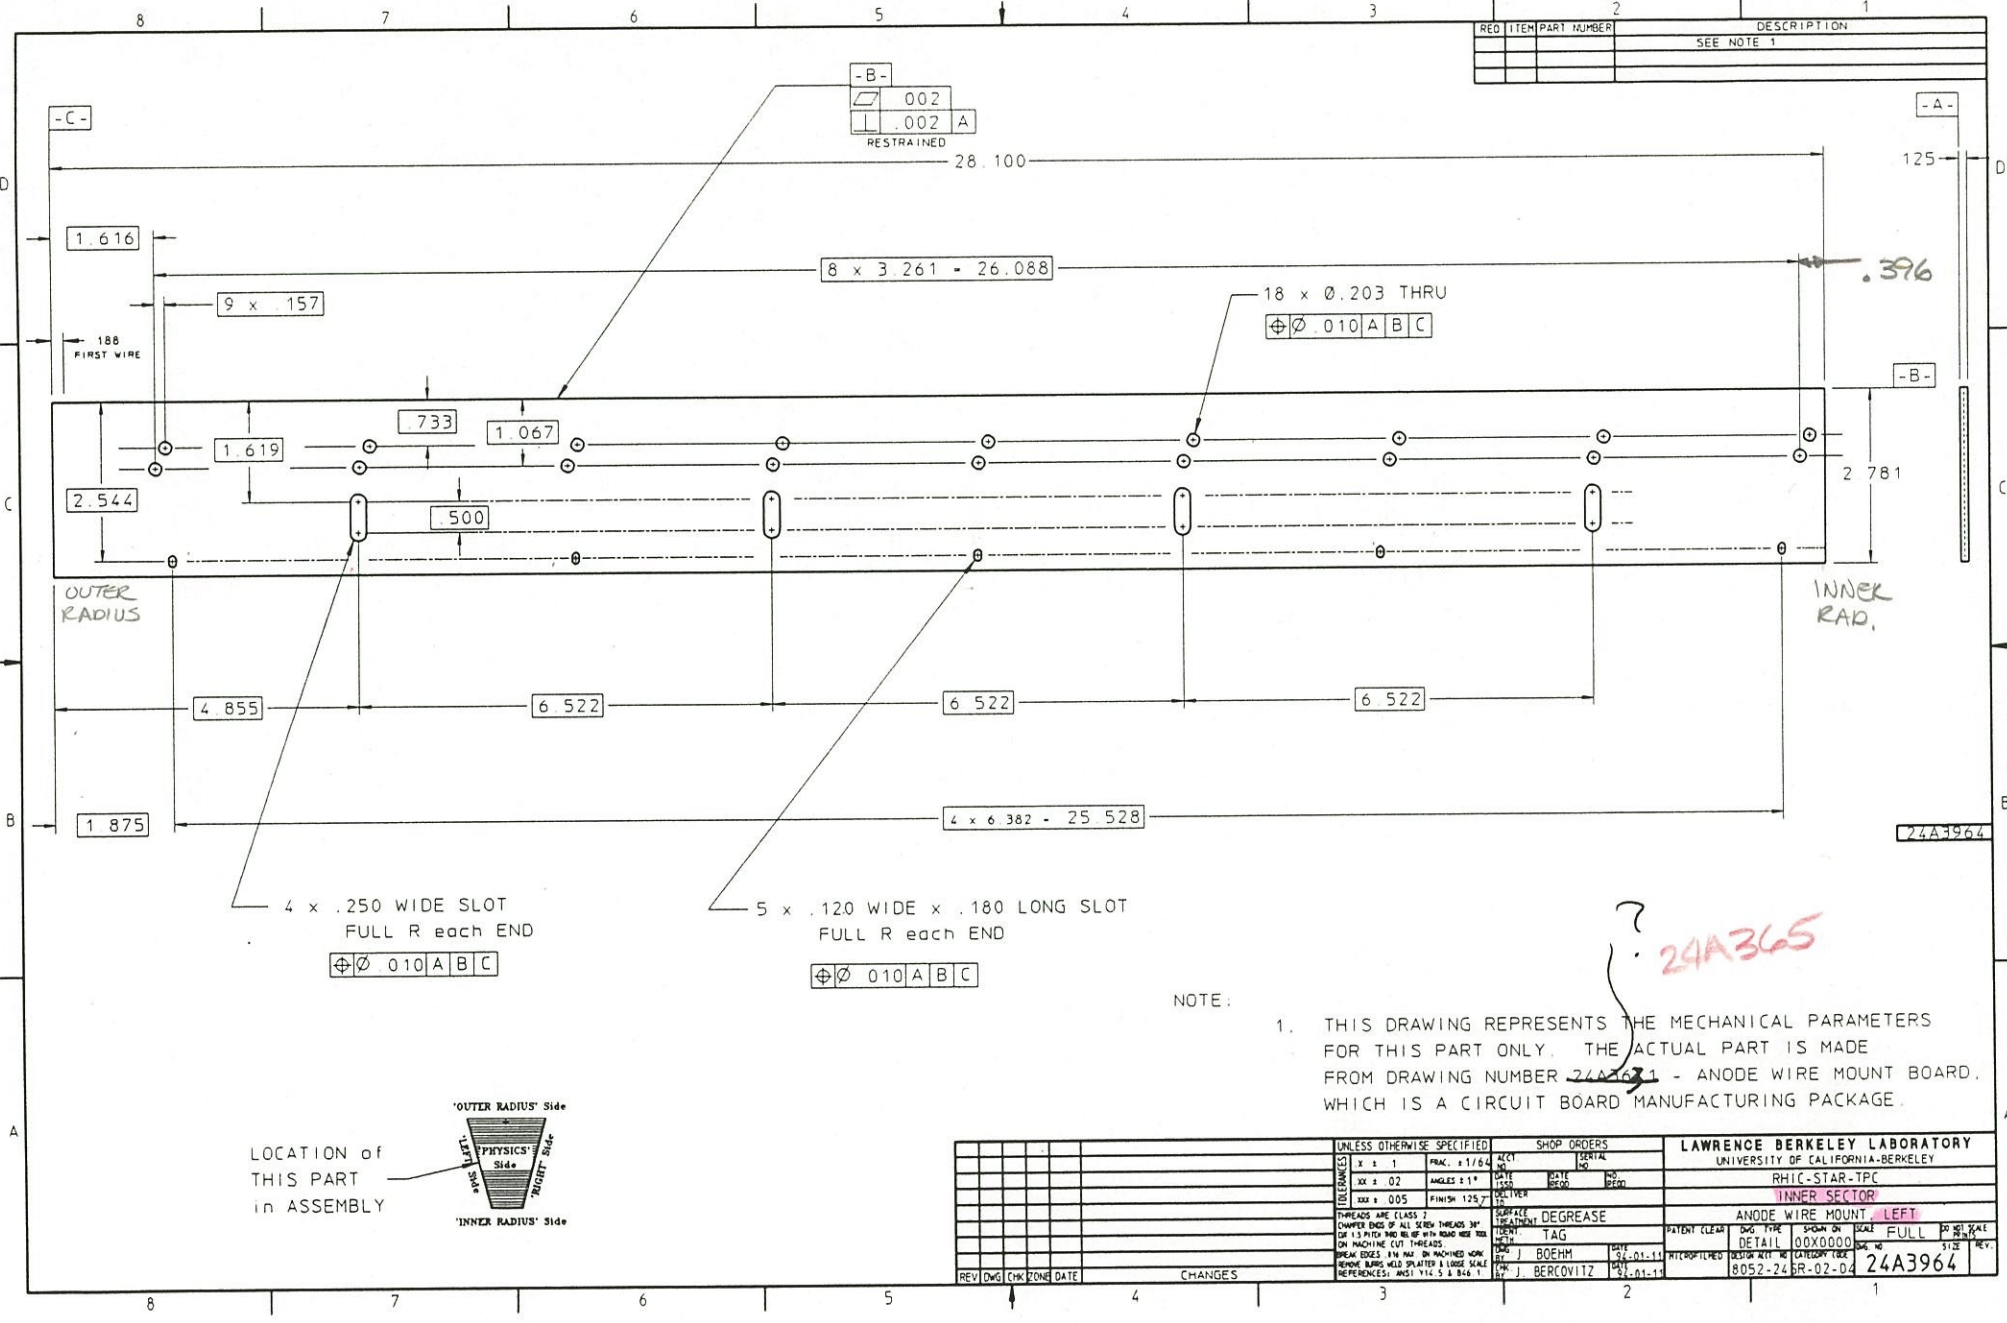

REV	ITEM	PART NUMBER	DESCRIPTION
			SEE NOTE 1

REV	DWG	CHK	ZONE	DATE	CHANGES

UNLESS OTHERWISE SPECIFIED		SHOP ORDERS	
QUANTITY	X 1	ALCY NO	CENTRAL NO
TERMINATION	FRAC. ± 1/64	DATE	DATE
	ANGLES ± 1°	BY	BY
		BY	BY


LAWRENCE BERKELEY LABORATORY			
UNIVERSITY OF CALIFORNIA-BERKELEY			
RHIC-STAR-TPC			
INNER SECTOR			
ANODE WIRE MOUNT, LEFT			
PATENT CLEAR	DWG TYPE	SPOKE BY	SCALE
			FULL
			FR
			REV
DWG	J BOEHRM	DATE	92-01-11
CHK	J BERCOVITZ	DATE	92-01-11
ITEROP/ITER	DESIGN WITH NO	CATEGORY	8052-24
			BR-02-04
			24A3964

27.547

~~27.221~~ = 169 sp. @ .163

170
168 WIRES


163 → ←

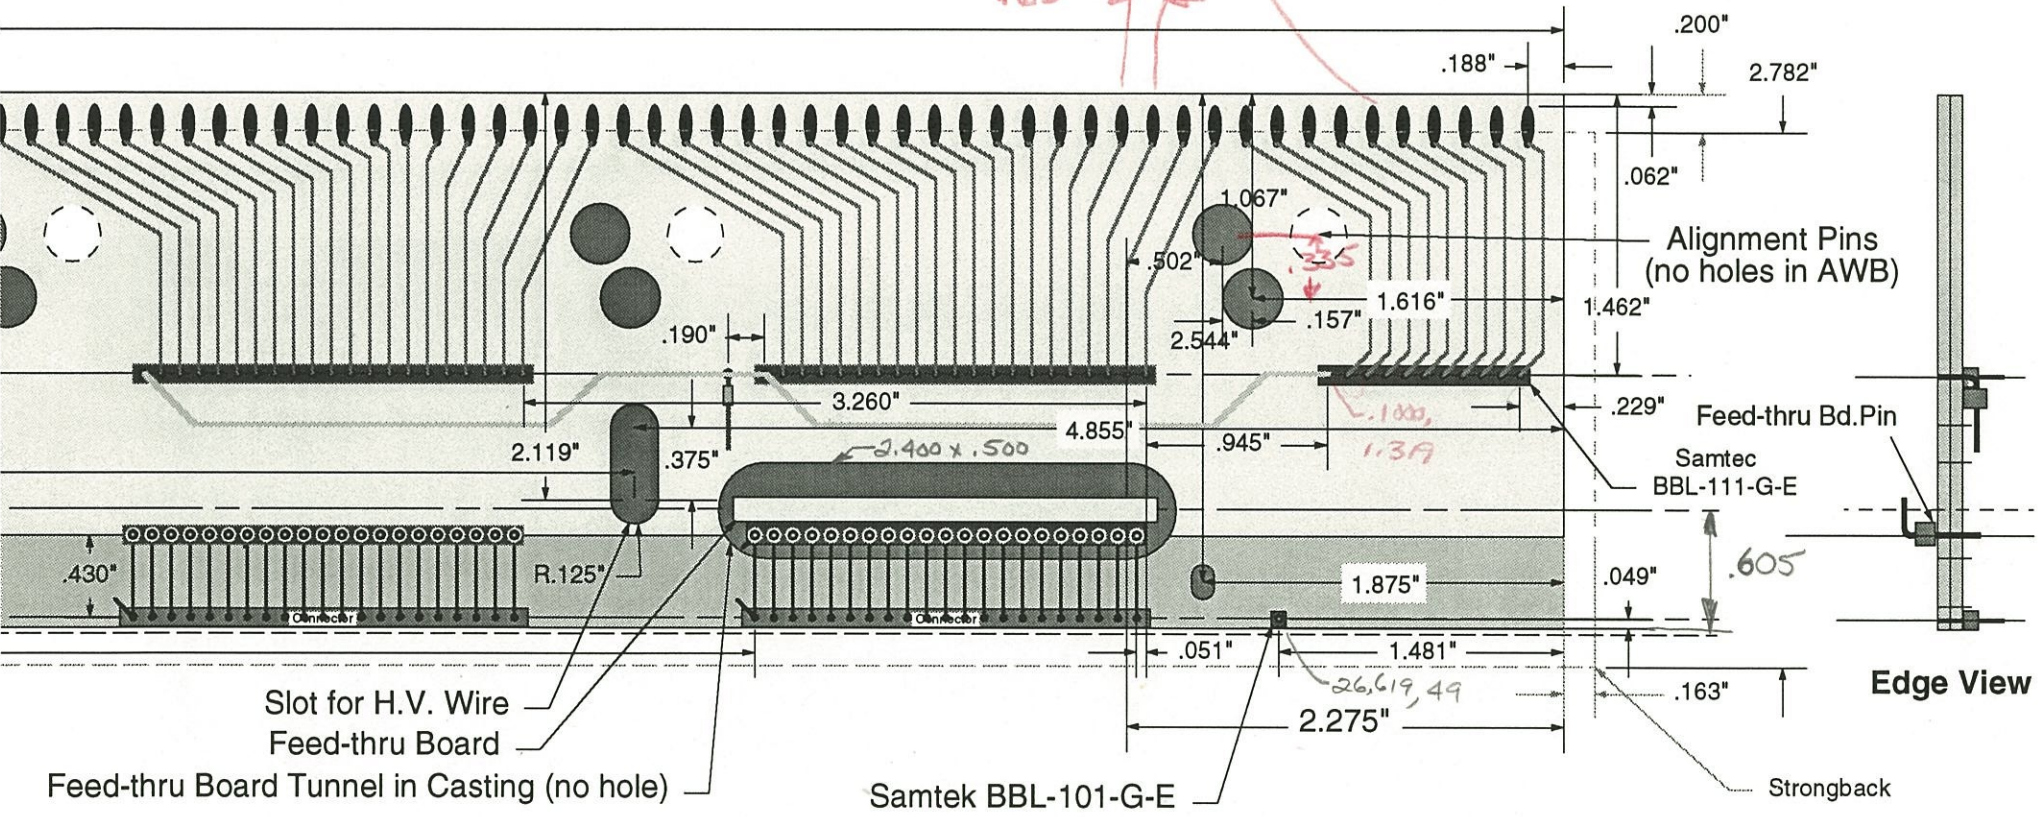

Outer Radius

✓ slot max
 ✓ slot min sp
 ✓ cn 21 row 1
 ✓ pad 7526c
 140 hole
 ✓ cn 21 row
 ✓ cn tra
 ✓ oval 6

hvcir1

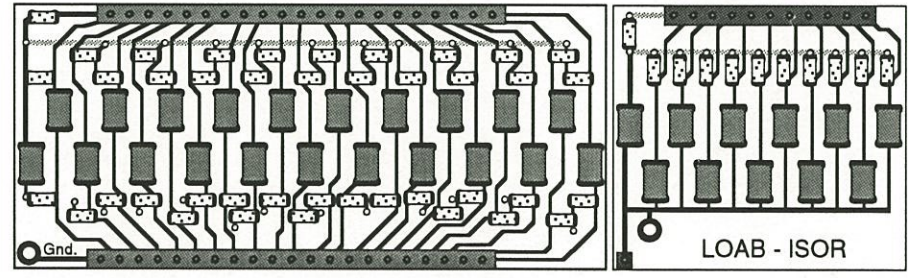


a000892u1

24A3651

Star TPC Anode Wire Mount, Inner Sector

28.100"

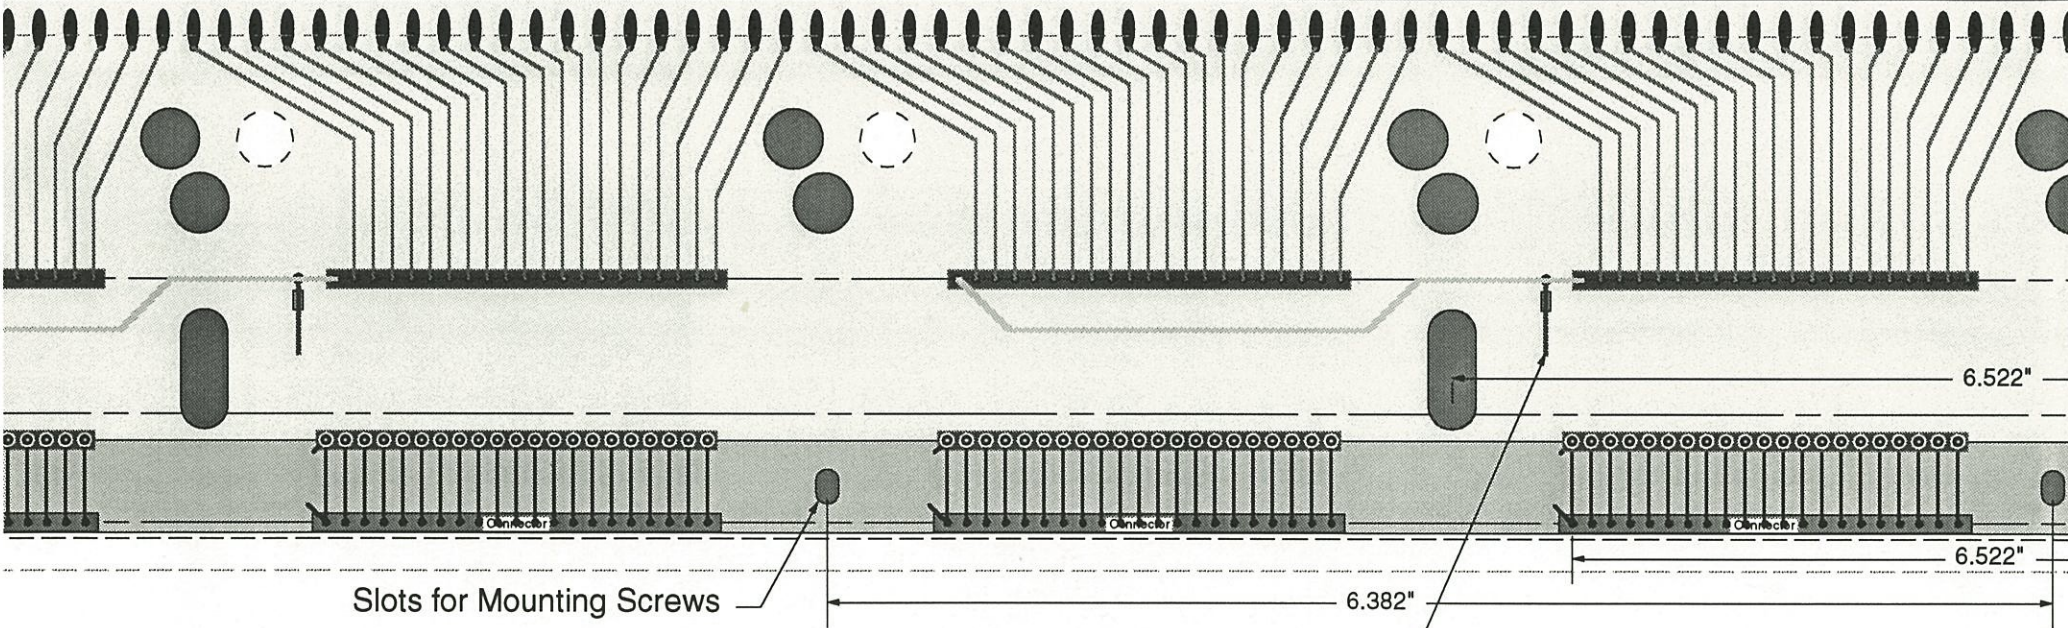


AMP 104716-1 (4 places)
or SAMTEC HMTSW-1-1-08-S-S230-RA

SCALE: 1X

Pad Plane Side Up





As Viewed from the Aluminium Strongback

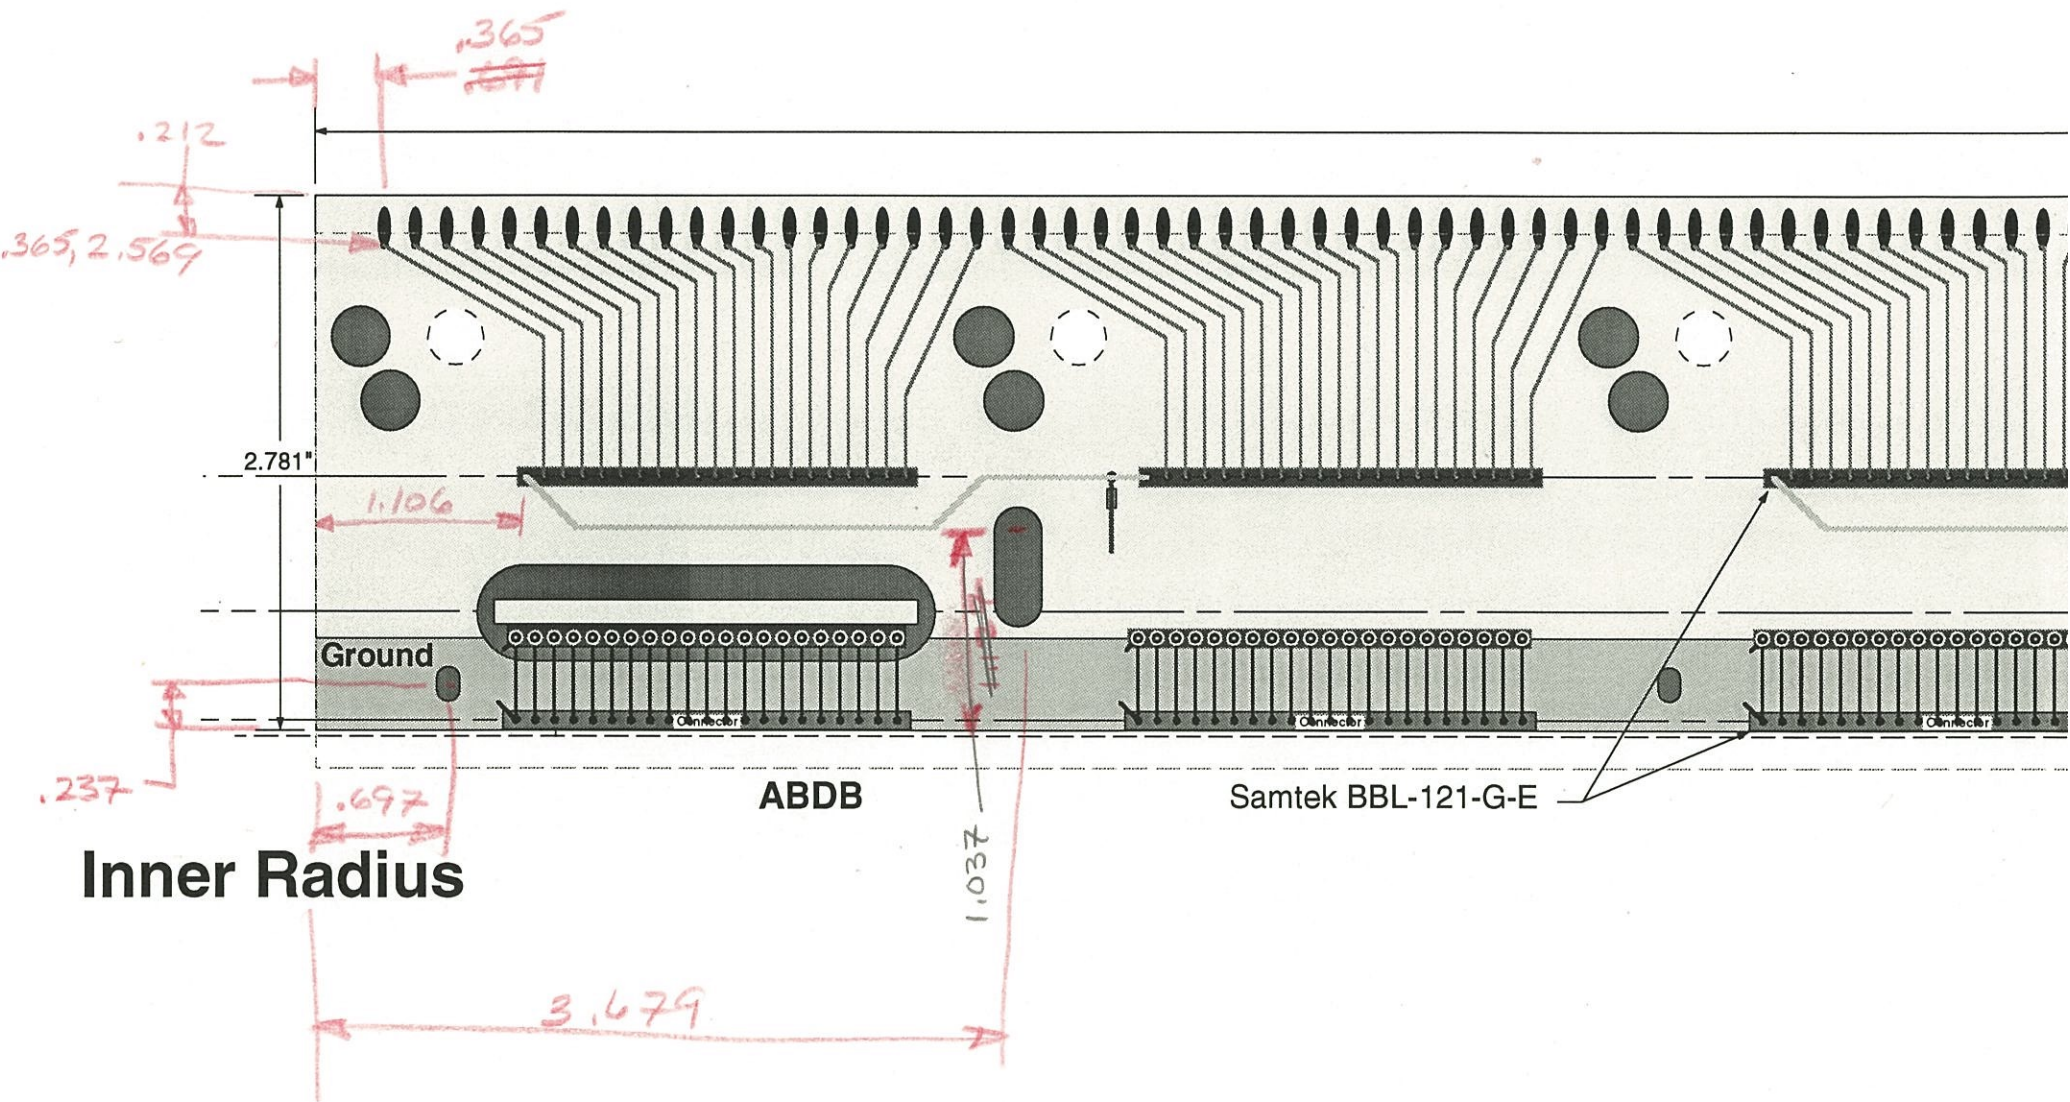

Inner Radius

REV	ITEM	PART NUMBER	DESCRIPTION
			HIGH PRESSURE EPDM/GLASS WEAVE LAMINATE, DET FED SPECS
			LF5090, TYPE 4 GRADE G-10 (NON-FR-4)

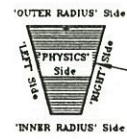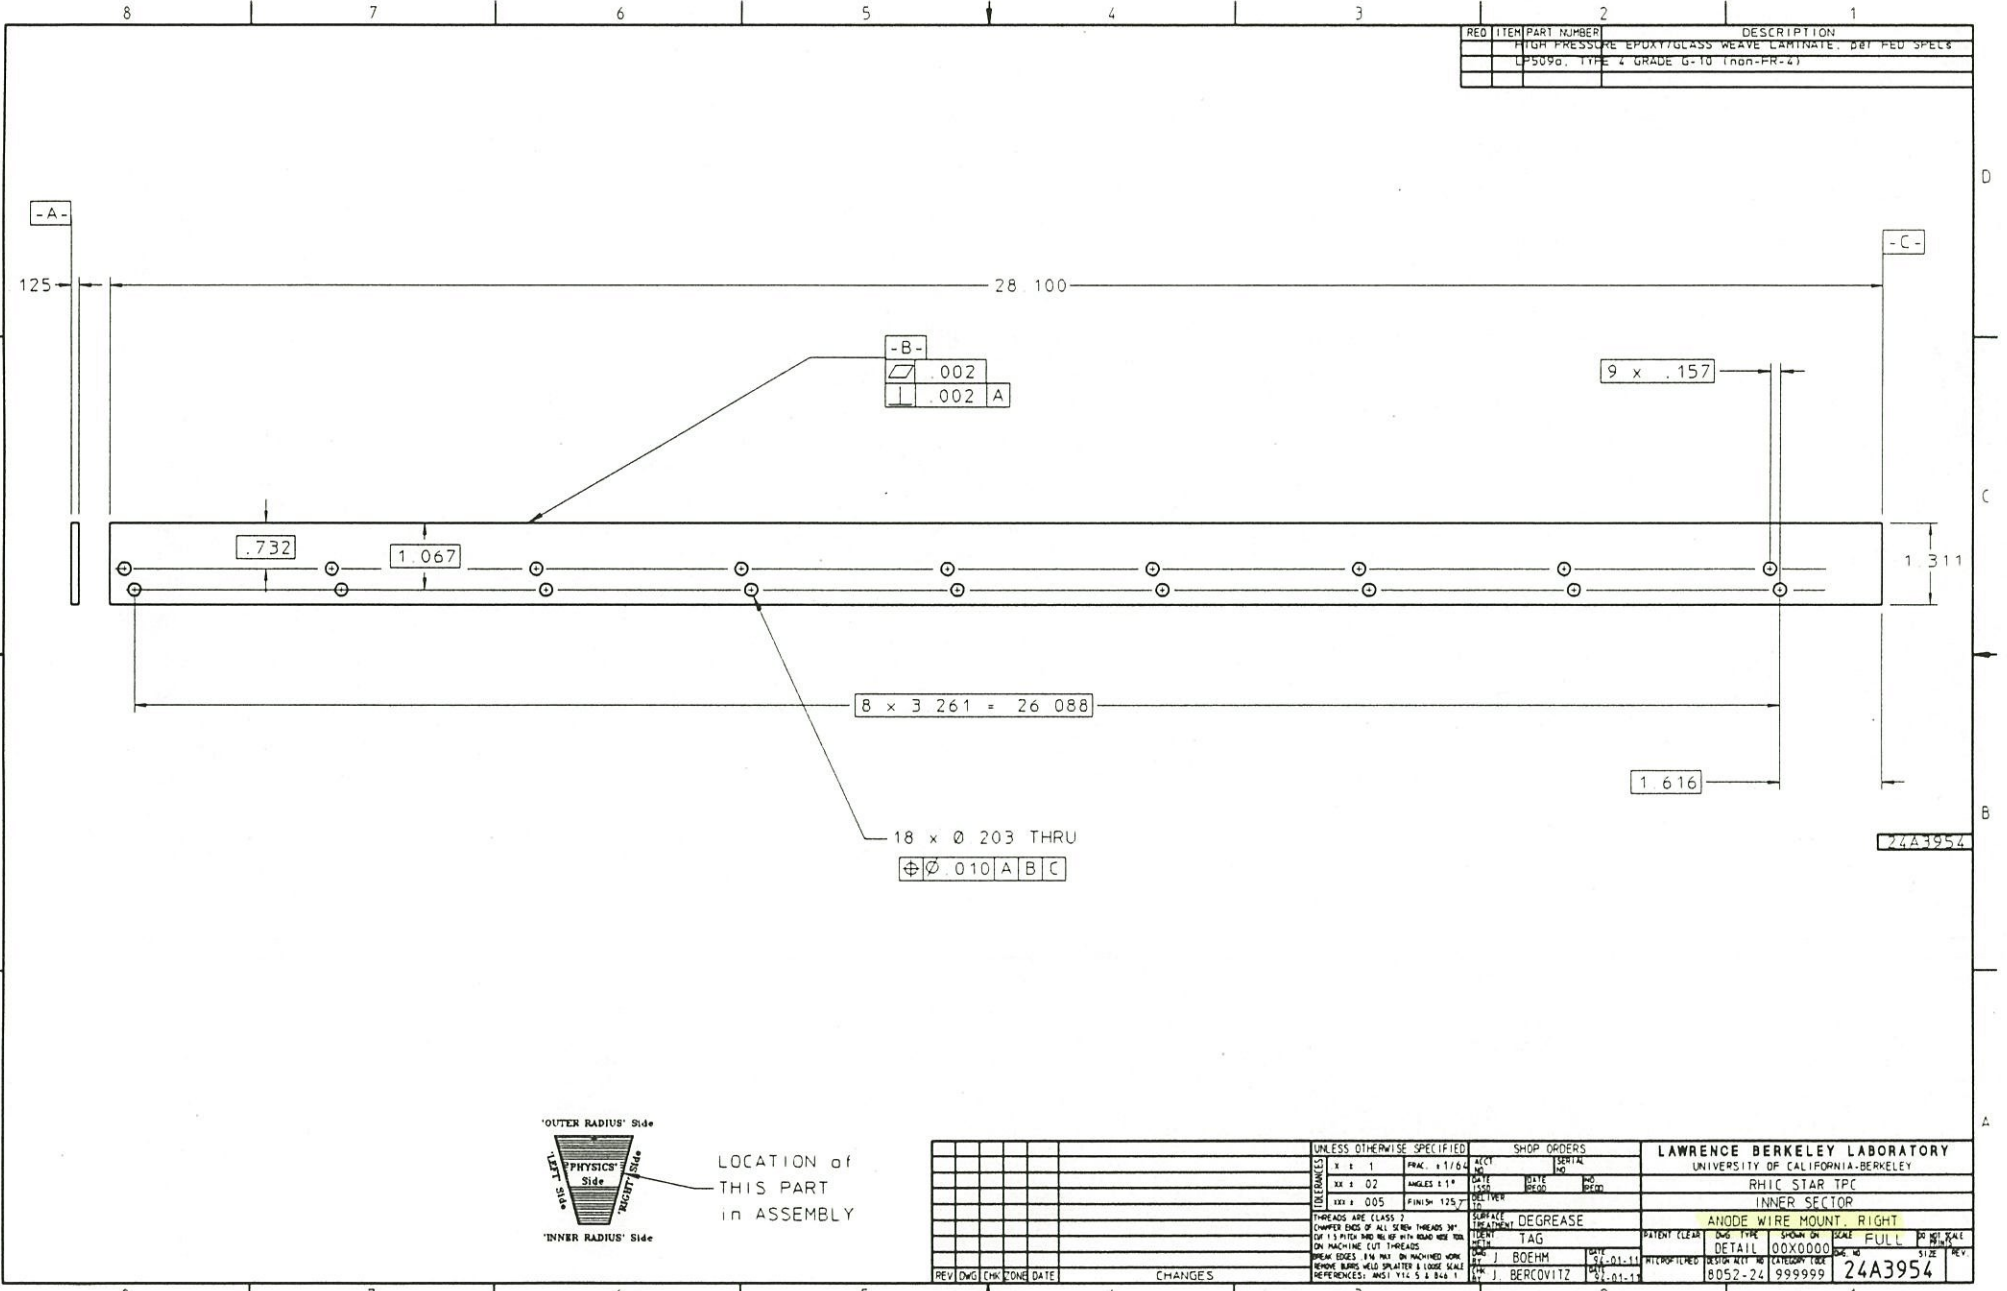

LOCATION of
THIS PART
in ASSEMBLY

REV	DWG	CHK	DATE	CHANGES

UNLESS OTHERWISE SPECIFIED				SHOP ORDERS			
CO	1	FRAC	1/2	QC		SERIAL	
XX	02	ANGLES	± 1°	DATE		NO	
XXX	005	FINISH	125.7	BY		NO	

LAWRENCE BERKELEY LABORATORY			
UNIVERSITY OF CALIFORNIA-BERKELEY			
RHIC STAR TPC			
INNER SECTOR			
ANODE WIRE MOUNT, RIGHT			
PATENT CLEAR	DWG TYPE	SCALE	DATE
	TAG	00X0000	
BY	DATE	REV	
BY J. BOEHM	01-11		
BY J. BERCOVITZ	01-11		
INTERFILMED	REVISION NO	8052-24	999999
			24A3954

4/12/94

HP EGS PHOTO PLOT/DRILL POST-PROCESSOR

AUTOFLASH: ON
ERROR MODE: PAUSE ON ERROR
FILL WIDTH MODE: ON

SORT DRILL: MAJOR SORT ON X
SORT PROXIMITY: X: 5.00000000000000L+002 Y: 5.00000000000000L+0
SORT APERTURE: ON

DRILL FORMAT: 5.1
PHOTO PLOT FORMAT: 5.0
DR ORIGIN SOURCE: -3.00L+002, 1.84L+004 OUTPUT: 5.00L+002, 5.00L+002
PH ORIGIN SOURCE: -3.00L+002, 1.84L+004 OUTPUT: 5.00L+002, 5.00L+002

DRILL UNITS FACTOR: 1.00L+000
PHOTO PLOT UNITS FACTOR: 1.00L+000
PHOTO PLOT RESOLUTION: 3.00L+000

NO FILL USE: none specified
NOTE USE: tr10
POLYGON FILL USE: none specified

ATTRIBUTES FILE: /lb1/jobs/a892/RE892DR2
WHEEL FILE: /users/sisu/wlb11

CURRENT HP EGS GENERATE SOURCE FILES:
/lb1/jobs/a892/a892dr2_g

NO VIRTUAL DRILL FILES HAVE BEEN SPECIFIED.

ACTUAL DRILL FILE:
/lb1/jobs/a892/PL892DR2
1 56

NO VIRTUAL PHOTO PLOT FILES HAVE BEEN SPECIFIED.

NO ACTUAL PHOTO PLOT FILES HAVE BEEN SPECIFIED.

TOOL LIST

tool number count diameter

1	92	1.25L+002
2	2088	2.60L+001
3	1032	3.80L+001
4	108	1.40L+002

WHEEL FILE DATA

aperture name
aperture number count type shape width height

4/12/94

HP EGS PHOTO PLOT/DRILL POST-PROCESSOR

AUTOFLASH: ON
ERROR MODE: PAUSE ON ERROR
FILL WIDTH MODE: ON

SORT DRILL: MAJOR SORT ON X
SORT PROXIMITY: X: 5.00000000000000L+002 Y: 5.00000000000000L+0
SORT APERTURE: ON

DRILL FORMAT: 5.1
PHOTO PLOT FORMAT: 5.0
DR ORIGIN SOURCE: -3.00L+002, 1.84L+004 OUTPUT: 5.00L+002, 5.00L+002
PH ORIGIN SOURCE: -3.00L+002, 1.84L+004 OUTPUT: 5.00L+002, 5.00L+002

DRILL UNITS FACTOR: 1.00L+000
PHOTO PLOT UNITS FACTOR: 1.00L+000
PHOTO PLOT RESOLUTION: 3.00L+000

NO FILL USE: none specified
NOTE USE: tr10
POLYGON FILL USE: none specified

ATTRIBUTES FILE: /lb1/jobs/a892/RE892DR1
WHEEL FILE: /users/sisu/wlb11

CURRENT HP EGS GENERATE SOURCE FILES:
/lb1/jobs/a892/a892dr1_g

NO VIRTUAL DRILL FILES HAVE BEEN SPECIFIED.

ACTUAL DRILL FILE:
/lb1/jobs/a892/PL892DR1
23 56

NO VIRTUAL PHOTO PLOT FILES HAVE BEEN SPECIFIED.

NO ACTUAL PHOTO PLOT FILES HAVE BEEN SPECIFIED.

TOOL LIST
tool number count diameter

1	1020	2.00L+001	OK
---	------	-----------	----

WHEEL FILE DATA
aperture name
aperture number count type shape width height

PRINT LIST

TITLE: STAR TPC
 INNER SECTOR ELECTRONICS
 ANODE WIRE MOUNT BOARD
 (PANEL OF SIX BOARDS)

FILE NO.: a0000992p1 REV:
 PRINT NO.: 24A3651 P-1
 CHANGES (*)

ENGINEER: JIM HUNTER
 DRAFTER: STIRKKINEN

DATE: 04/14/94
 PAGE: 1 OF 1

Drawing No.	Chg. Ltr.	Title
24A3651 C-1 (a0000992c1)		PARTS LIST (PANEL)
24A3654 M-1 (a0000992m1)		BOARD OUTLINE - CUTOUTS (PANEL)
24A3654 M-2 (a0000992m2)		BOARD OUTLINE (PANEL)
24A3654 E-1 (a0000992e1)		HOLE SCHEDULE - BLIND VIAS
24A3654 E-2 (a0000992e2)		HOLE SCHEDULE - LAYERS 1 THRU 4
24A3654 L-1 (a0000992l1)		P.C. BOARD ASSEMBLY (PANEL)
24A3651 U-1 (a0000992u1)		ARTWORK - SINGLE BOARD LAYER 1 - GROUND PLANE LAYER 2 - PADS LAYER 3 - H.V. CIRCUIT LAYER 4 - OUTER TRACE LAYER
24A3651 U-2 (a0000992u2)		ARTWORK - PANEL OF SIX 24A3651 U-1'S

** THE FOLLOWING DRAWING NOT REQUIRED FOR THIS PACKAGE:
 SILKSCREEN

*

PARTS LIST

TITLE: STAR TPC
INNER SECTOR ELECTRONICS
ANODE WIRE MOUNT BOARD
(PANEL OF 6)

FILE NO.: a000892c1 REV:
PRINT NO.: 24A3651 C-1
CHANGES (*)

ENGINEER: JIM HUNTER
DRAFTER: STIRKKINEN

DATE: 04/14/94
PAGE: 1 OF 1

Reference	Stock No.	Part Type	Description	Qty

		HARDWARE		
-	NS	BBL-111-G-E	11 PIN SOCKET,STRAIGHT, SAMTEC #BBL-111-G-E	6
-	NS	BBL-121-G-E	21 PIN SOCKET,STRAIGHT, SAMTEC #BBL-121-G-E	96
-	NS	BBL-101-G-E	1 PIN SOCKET,STRAIGHT, SAMTEC #BBL-101-G-E	6
-	NS	104716-1	1 PIN CONNECTOR,RIGHT ANGLE,AMP #104716-1 OR SAMTEC #HMTSW-1-1-08-S- S230-RA	24
-	NS	a000892u2	24A3651 U-2,PRINTED CIRCUIT BOARD (PANEL OF 6 24A3651 U-1, a000892u1)	1

***** LBL BOARD A000892U2 *****
***** MAY 16, 1994 *****
***** WHEEL W892INFO *****
NEED 3 STANDARD PHOTOPLOTS, 1 COMPOSITE, 4 POSITIVES AND 4 NEGATIVES.
DELIVERY DATE: MAY 19, 1994 OR SOONER.

PHOTOPLOT FILES IN POSITIVE FORMAT:

PL892L1C - LAYER 1 (DROP-IN-LAYER)
PL892L2 - LAYER 2 PADS ONLY (INNER LAYER)
PL892L3 - LAYER 3 H.V. CIRCUIT (INNER LAYER)
PL892L4 - LAYER 4 (OUTER LAYER)

PHOTOPLOT FILE IN NEGATIVE FORMAT:

PL892L1G - LAYER 1 (CLEARANCE LAYER)

FOR LAYER 1 COMPOSITE, USE PLOT FILE PL892L1C (POSITIVE) AND PL892L1G (NEGATIVE).

PLEASE MAKE CONTACT COPIES OF PLOT FILES (3) AND COMPOSITE (1). I NEED ONE (1) POSITIVE AND ONE (1) NEGATIVE OF EACH FILE, EMULSION DOWN, RIGHT READING. THIS IS A TOTAL OF FOUR (4) POSITIVES AND FOUR (4) NEGATIVES.

HI GARY! I UNDERSTAND THAT THE BLANKET ORDER WAS EXTENDED BY A FARE AMOUNT, SO I'M GOING TO PROCESS 4 SETS OF FILMS (ONLY) IN THE NEXT COUPLE OF DAYS. I THOUGHT I'D BETTER GET THEM OUT BEFORE SOMETHING ELSE HAPPENS. SEE YA!

IF THERE ARE ANY QUESTIONS OR PROBLEMS PLEASE CALL -JUDY- (916) 547-4005 OR -JIM- (510)486-7084.

tr10 10 circle trace 10;
tr12 11 circle trace 12;
tr15 12 circle trace 15;
tr20 13 circle trace 20;
tr30 14 circle trace 30;
tr40 15 circle trace 40;
tr50 16 circle trace 50;
tr60 17 circle trace 60;
tr70 18 circle trace 70;
tr80 19 circle trace 80;
tr90 20 circle trace 90;
tr100 21 circle trace 100;
tr120 20 circle trace 120;
tr130 21 circle trace 130;
tr150 22 circle trace 150;
f140 23 circle flash 40;
f150 24 circle flash 50;
f160 25 circle flash 60;
f170 26 circle flash 70;
f175 27 circle flash 75;
f185 28 circle flash 85;
f190 29 circle flash 90;
f1100 72 circle flash 100;
f1110 73 circle flash 110;
f1120 30 circle flash 120;
f1130 31 circle flash 130;
f1140 32 circle flash 140;
f1150 33 circle flash 150;
f1160 34 circle flash 160;
f1200 35 circle flash 200;
PADEX0 36 rectangle flash 80 55;
PADEX0 37 rectangle flash 55 80;
PADEXR 38 rectangle flash 75 55;
PADEXR 39 rectangle flash 55 75;
ftarget 40 square special 1.0;
fs60 41 square flash 60;
fs70 42 square flash 70;
fs75 43 square flash 75;
fs85 44 square flash 85;
fs100 45 square flash 100;
fs110 46 square flash 110;
fs120 47 square flash 120;
fs130 48 square flash 130;
fs140 49 square flash 140;
fs150 50 square flash 150;

PRINT LIST

TITLE: STAR TPC
 INNER SECTOR ELECTRONICS
 LITTLE ORPHAN ANODE BOARD
 (PANEL OF 10 24A4511 U-1,
 a000897u1)

FILE NO.: a000897p1 REV: A
 PRINT NO.: 24A4511 P-1
 CHANGES (*) 09/28/94

ENGINEER: JIM HUNTER
 DRAFTER: STIRKKINEN

DATE: 04/15/94
 PAGE: 1 OF 1

Drawing No.	Chg. Ltr.	Title
24A4511 C-1 (a000897c1)		PARTS LIST (PANEL)
24A4512 M-1 (a000897m1)		BOARD OUTLINE (PANEL)
24A4512 E-1 (a000897e1)		HOLE SCHEDULE (PANEL)
24A4512 L-1 (a000897l1)	A	PC BOARD ASSEMBLY (PANEL) *
24A4511 U-1 (a000897u1)		PC BOARD - ISOR/10 WIRE (SINGLE BOARD)
24A4511 U-2 (a000897u2)		PC BOARD - ISOR/10 WIRE (PANEL)

** DRAWINGS NOT REQUIRED FOR THIS PACKAGE - SILKSCREEN **

NUMBERS WITHIN () REFER TO EGS COMPUTER FILES

* PARTS LIST

TITLE: STAR TPC
 INNER SECTOR ELECTRONICS
 LITTLE ORPHAN ANODE BOARD
 (PANEL OF 10 BOARDS)

FILE NO.: a000897c1 REV:
 PRINT NO.: 24A4511 C-1
 CHANGES (*)

ENGINEER: JIM HUNTER
 DRAFTER: STIRKKINEN

DATE: 04/15/94
 PAGE: 1 OF 1

Reference	Stock No.	Part Type	Description	Qty
CAPACITORS				
C1,C2,C3,C4,C5, C6,C7,C8,C9, C10,C11	NS	.001uF	.001uF,3KV,CERAMIC,SMT, SIZE .120 X .180	110
RESISTORS				
R1,R2,R3,R4,R5, R6,R7,R8,R9, R10,R11	NS	10M	10M,1/8W,5%,SMT,SIZE	110
MISCELLANEOUS				
J1	NS	CN11SROW	11 PIN,SINGLE ROW CON- NECTOR,STRAIGHT,SAMTEC #SSK-111-S-G,SOLDER TAIL	10
-	NS	CN1SROW	1 PIN,SINGLE ROW CON- NECTOR,STRAIGHT,SAMTEC #SSK-101-S-G,SOLDER TAIL	4
-	NS	24A4511 U-2 (a000897u2)	24A4511 U-2,PC BD,PANEL OF 10 BOARDS (24A4511 U-1 , a000897u1)	1

MAY 9, 1995

HI FRANK:

THERE ARE A TOTAL OF 4 GERBER FILES. THEY ARE AS FOLLOWS:

P897C - COMPONENT SIDE CIRCUIT (POSITIVE FORMAT)
P897S - SOLDER SIDE - PADS AND TRACES (POSITIVE FORMAT)
P897G - SOLDER SIDE GROUND CLEARANCES (NEGATIVE FORMAT)
P897SP - SOLDER PASTE - COMPONENT SIDE (NEGATIVE FORMAT)


THERE ISN'T A SILKSCREEN OR SOLDERMASK FOR THIS BOARD.

PLEASE ACCEPT MY APOLOGY ON THIS MIX UP. I HOPE THIS WILL TAKE CARE OF WHAT YOU NEED, IF NOT PLEASE CALL ME (JUDY) AT (916) 547-4005. HAVE A GOOD ONE. - JUDY

THE APERTURE LIST IS AS FOLLOWS:

tr10 10 circle trace 10;
tr12 11 circle trace 12;
tr15 12 circle trace 15;
tr20 13 circle trace 20;
tr30 14 circle trace 30;
tr40 15 circle trace 40;
tr50 16 circle trace 50;
tr60 17 circle trace 60;
tr70 18 circle trace 70;
tr80 19 circle trace 80;
tr90 70 circle trace 90;
tr100 71 circle trace 100;
tr120 20 circle trace 120;
tr130 21 circle trace 130;
tr150 22 circle trace 150;
fl40 23 circle flash 40;
fl50 24 circle flash 50;
fl60 25 circle flash 60;
fl70 26 circle flash 70;
fl75 27 circle flash 75;
fl85 28 circle flash 85;
fl90 29 circle flash 90;
fl100 72 circle flash 100;
fl110 73 circle flash 110;
fl120 30 circle flash 120;
fl130 31 circle flash 130;
fl140 32 circle flash 140;
fl150 33 circle flash 150;
fl160 34 circle flash 160;
fl200 35 circle flash 200;
PADEX0 36 rectangle flash 80 55;
PADEX0 37 rectangle flash 55 80;
PADEXR 38 rectangle flash 75 55;
PADEXR 39 rectangle flash 55 75;
ftarget 40 square special 1.0;
fs60 41 square flash 60;
fs70 42 square flash 70;
fs75 43 square flash 75;
fs85 44 square flash 85;
fs100 45 square flash 100;
fs110 46 square flash 110;
fs120 47 square flash 120;
fs130 48 square flash 130;
fs140 49 square flash 140;
fs150 50 square flash 150;
PADEX05 51 rectangle flash 65 55;
PADEX05 52 rectangle flash 55 65;
fr12040 53 rectangle flash 120 40;
fr16040 54 rectangle flash 160 40;
fr4860 55 rectangle flash 48 60;
fr4075 56 rectangle flash 40 75;
fr4030 57 rectangle flash 40 30;
fr13030 58 rectangle flash 130 30;
fr3040 59 rectangle flash 30 40;
fl30 60 circle flash 30;
fl180 61 circle flash 180;
fs45 62 square flash 45;
fr9040 63 rectangle flash 90 40;
fr4090 64 rectangle flash 40 90;
fr10030 65 rectangle flash 100 30;
fr30100 66 rectangle flash 30 100;


REV.	CHANGES	DRAWN	DATE	CHKD.	DATE
A	DRAWING NO. WAS 24A4512 L-2.	JJS	09/28/94		

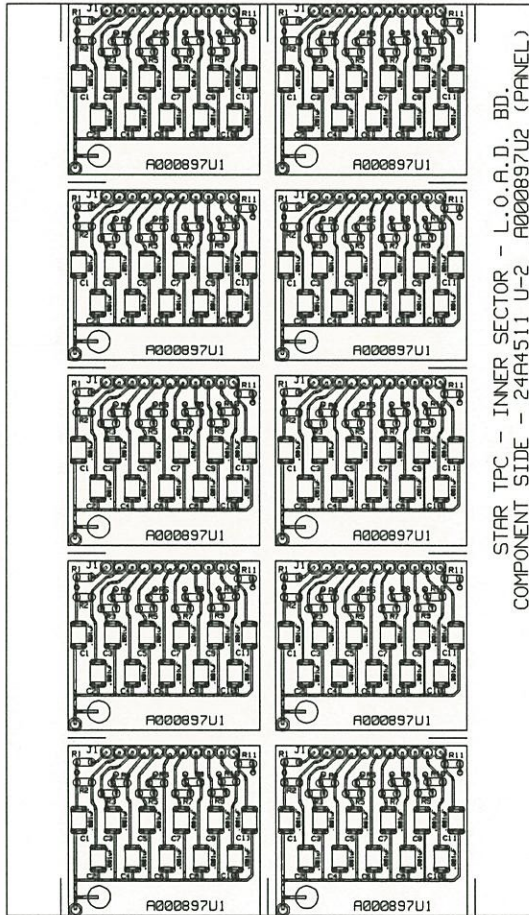

STAR TPC - INNER SECTOR - L.O.A.D. BD.
COMPONENT SIDE - 24A4511 U-2 A000897U2 (PANEL)

11 PIN SOCKET, SAMTEC
#SSK-111-S-G (10 PLACES)

1 PIN SOCKET, SAMTEC
#SSK-101-S-G (10 PLACES)

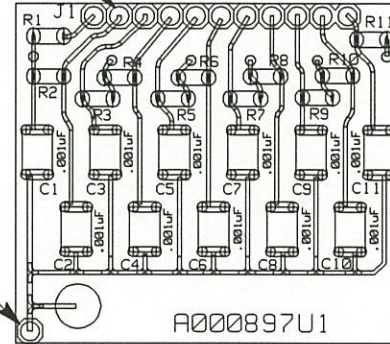

SCALE: ~2:1


NOTES:

- UNLESS OTHERWISE SPECIFIED:
 - A. RESISTORS ARE 10M, 1/8W, 5%, SURFACE MOUNT, SIZE 1206.
 - B. CAPACITORS ARE .001uF, 3KV, CERAMIC, SURFACE MOUNT, SIZE .120" X .180".
- PANEL BOARD SIZE IS 4.200 +/- .010 X 7.350 +/- .005. SINGLE BOARD SIZE IS 1.520 X 1.370 +/- .005. DIMENSIONS ARE IN INCHES. BOARD OUTLINE IS 24A4512 M-1 (a000897m1).
- REFERENCE DRAWINGS:

24A4511 C-1	a000897c1	PARTS LIST (PANEL)
24A4512 M-1	a000897m1	BOARD OUTLINE (PANEL)
24A4512 E-1	a000897e1	HOLE SCHEDULE (PANEL)

D I S T R I B U T I O N		TITLE		STAR TPC			
		II:		INNER SECTOR ELECTRONICS			
		III:		LITTLE ORPHAN ANODE BOARD (ISOR)-10 WIRES			
SHOWN ON				P.C. BD. ASSY - PANEL OF 10 (24A4511 U-2)			
ACCOUNT NUMBER	8052-24	DRAWN	STIRKKINEN	DATE	04/15/94	LAWRENCE BERKELEY LABORATORY	
SERIAL NUMBER		CHECKED		DATE		UNIVERSITY OF CALIFORNIA	
DATE ISSUED	NO. RECD.	APPROVED		DATE		OFFICE OF ELECTRONICS ENGINEERING	
DATE RECD.		ENGINEER	JIM HUNTER	FILE NO.	a00089711	SIZE	2
				DRAWING NO.	24A4512 L-1	REV.	A
DEL. TO		SCALE	NONE	E2, E3, E5, E27, E26, E52, E53			SHEET 1 OF 1

REV.	CHANGES	DRAWN	DATE	CHKD.	DATE

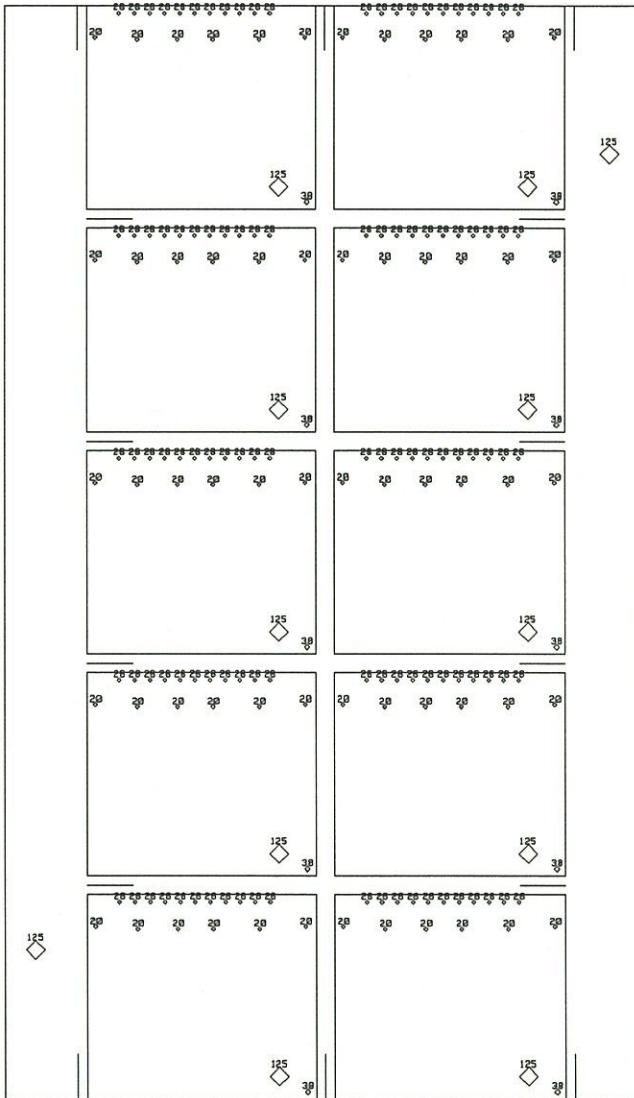


SOLDER SIDE VIEW

NOTES:

- BOARD MATERIAL: .062 THICK NEMA G10 GLASS EPOXY PER MIL-P-13949G FL-GEN 062C-1/1-A1A (1 OZ. COPPER BOTH SIDES).
- SEE HOLE SCHEDULE FOR HOLE SIZES.
- THIS BOARD TO BE THROUGH HOLE PLATED.
- SPECIFIED HOLE DIA. SIZES ARE FOR FINISHED HOLES AFTER PLATING.
- THIS PANEL BOARD IS NOT TO BE SILKSCREENED.
- PANEL SIZE IS 4.200 +/- .010 X 7.350 +/- .005. SINGLE BOARD SIZE IS 1.520 X 1.370 +/- .005. DIMENSIONS ARE IN INCHES. BOARD OUTLINE IS DRAWING 24A4512 M-1 (a000897m1).
- SOLDERMASK IS NOT USED ON THIS BOARD.
- REFERENCE DRAWINGS:
 24A4511 C-1 a000897c1 PARTS LIST (PANEL)
 24A4512 M-1 a000897m1 BOARD OUTLINE (PANEL)
 24A4512 L-1 a000897l1 P.C. BOARD ASSEMBLY (PANEL)

HOLE SCHEDULE		
TOOLING NO.	HOLE DIA.	COUNT
1	.026	110
2	.020	60
3	.038	10
4	.125	12

TOTAL HOLE COUNT = 192.

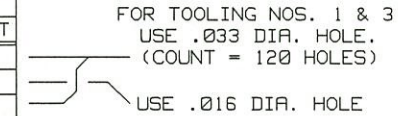

I:		TITLE STAR TPC			
II:		INNER SECTOR ELECTRONICS			
III:		LITTLE ORPHAN ANODE BOARD (ISOR)-10 WIRES			
SHOWN ON		HOLE SCHEDULE - PANEL OF 10 (24A4511 U-2)			
ACCOUNT NUMBER	8052-24	DRAWN	DATE	LAWRENCE BERKELEY LABORATORY	
SERIAL NUMBER		CHECKED	DATE	UNIVERSITY OF CALIFORNIA	
DATE ISSUED	NO. RECD.	APPROVED	DATE	FILE NO.	SIZE
DATE RECD.		ENGINEER	JIM HUNTER	a000897e1	2
DEL. TO		SCALE	NONE	C1,E2,E56	DRAWING NO. 24A4511 E-1
					REV. SHEET 1 OF 1

OBsolete 1/5/95
SEE REV A. - NO NET.
WORK CHANGE.

(5/17/94)

a000896u2 (PANEL OF 16)
GATED GRID WIRE MT. - INNER SECTOR

ORIGIN: -200, 10800
WHEEL W893

LAYER 1 ⇒ #E19 #E29 -P29 #E5 #E55 = a89611g

CM0896L1 ⇒ A896L1 ⇒ PL896L1

LAYER 2 ⇒ #E6 #E8 #E19 = a89612g

CM0896L2 ⇒ A896L2 ⇒ PL896L2

LAYER 3 ⇒ BLANK = NO PLOT

~~CM0896L3~~ ⇒ ~~A896L3~~

LAYER 4 ⇒ #E7 #E9 = a89614g

CM0896L4 = A896L4 = PL896L4


DRILL (BURIED VIAS) = #C1 #E56 = a896dr1g
CHANGE DRILL TO .015

DRILL (THRU VIAS) = #C23 #E56 = a896dr2g
CHANGE DRILL TO .028


24A450L

000896


Handwritten notes:
24A450L
000896
3/19/94

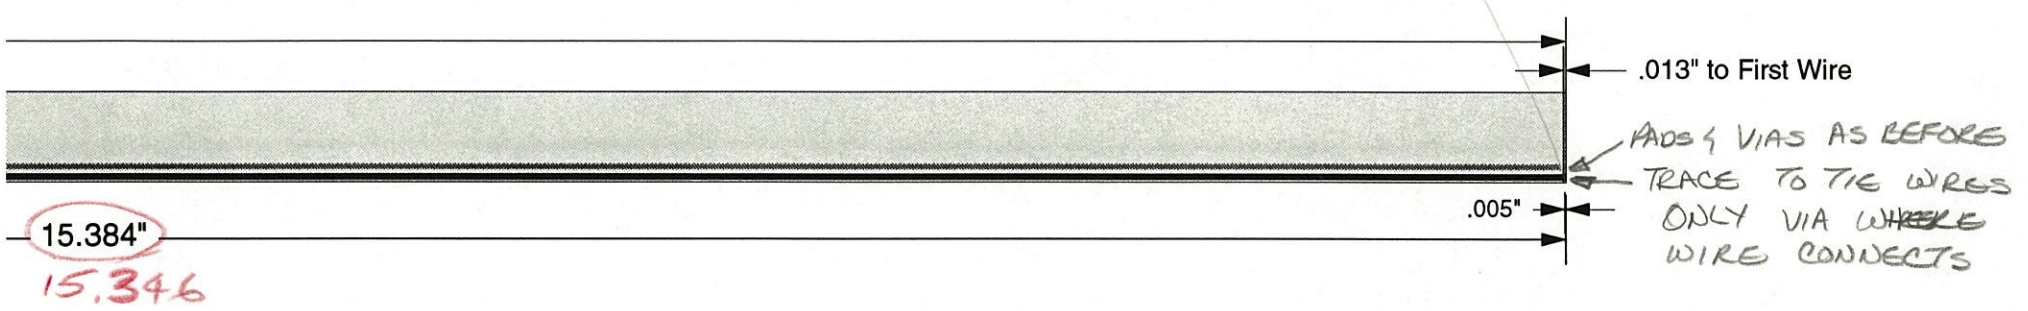


Outer Radius

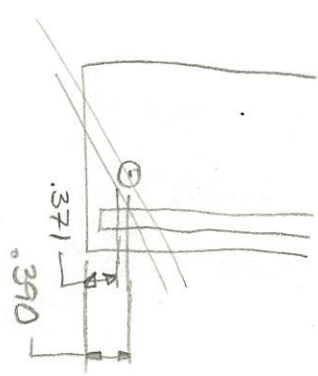


Handwritten notes:
15.384
15.346
3/8

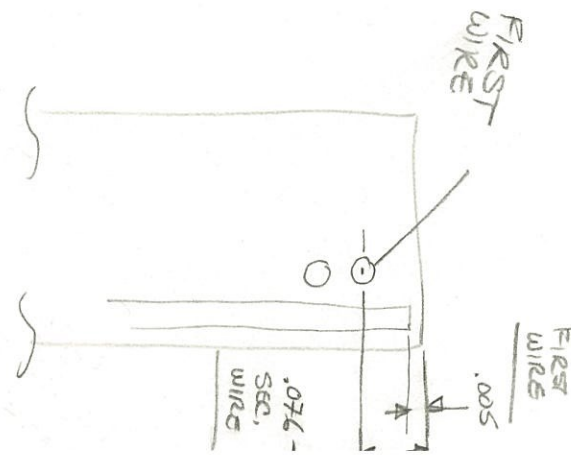


STAR Gated Grid Wire Mount P.C.B., Inner Sector

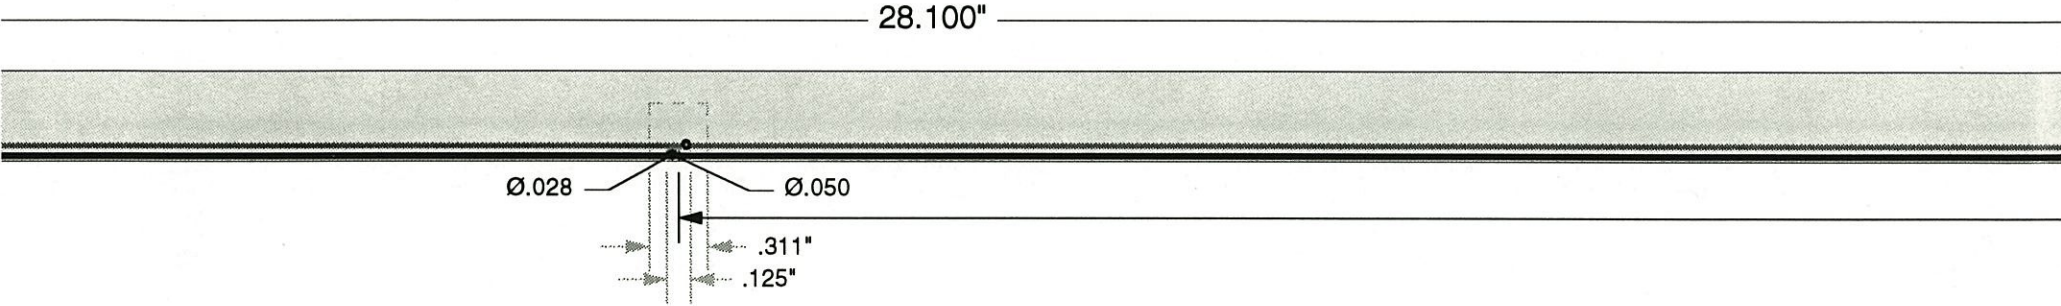

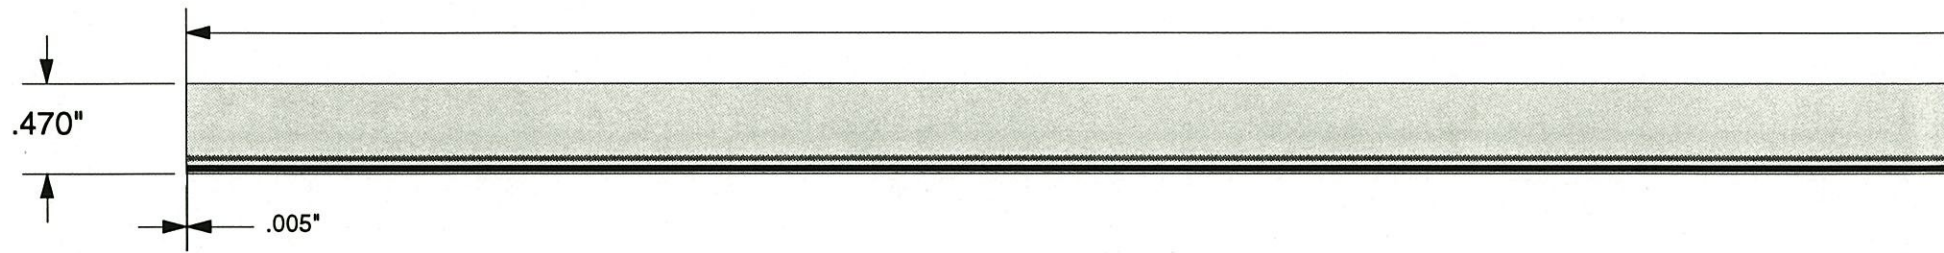


Inner Radius

REQ	ITEM	PART NUMBER	DESCRIPTION
		24A4023	INNER SECTOR GATED GRID WIRE MOUNT EXTRUSION

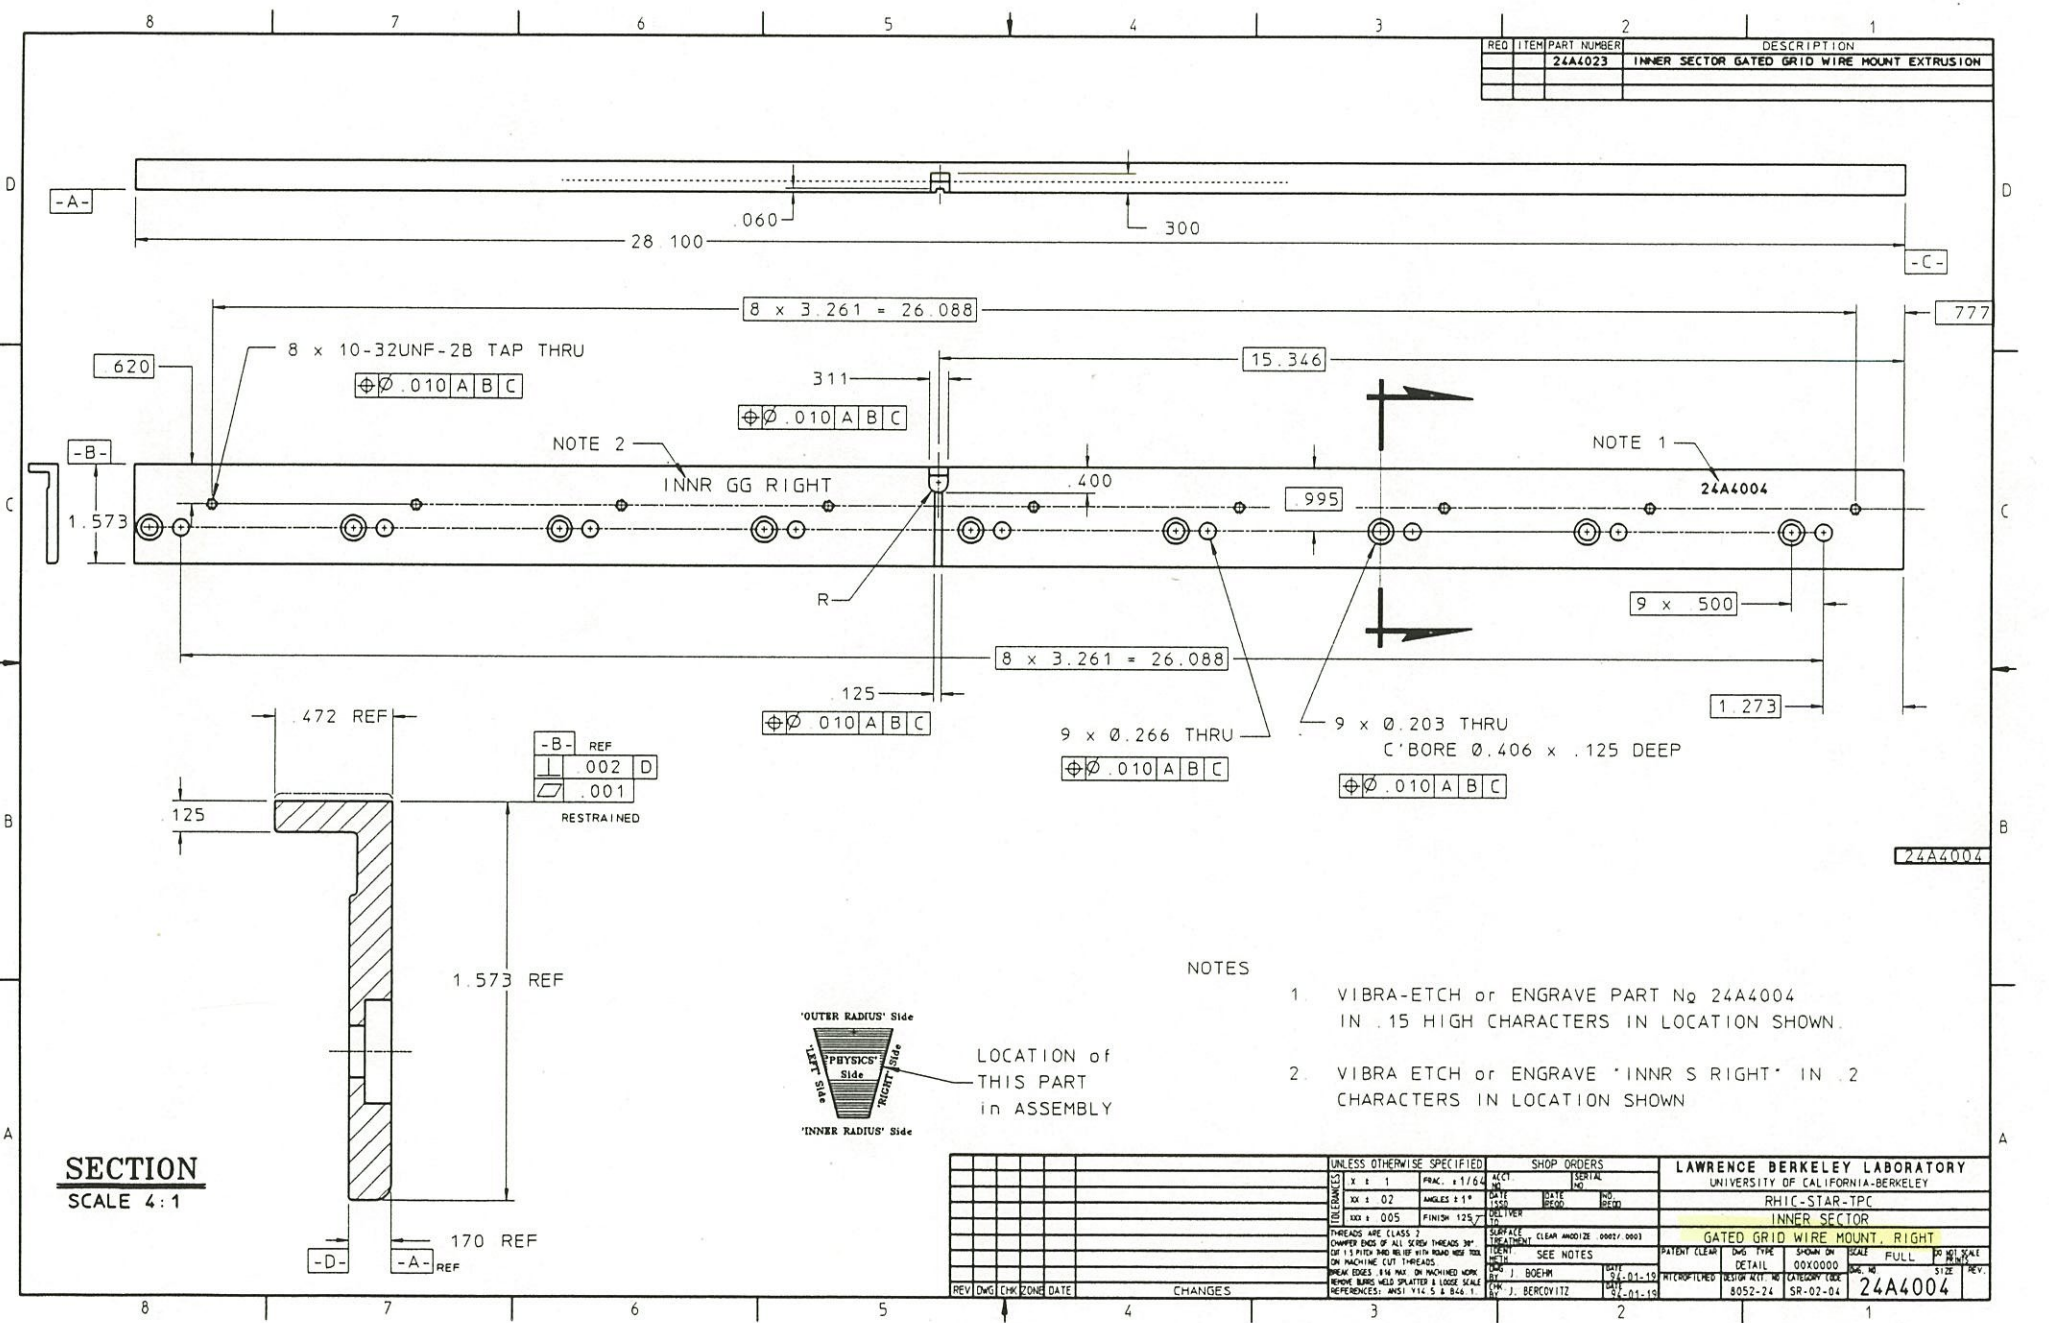


NOTES

- VIBRA-ETCH or ENGRAVE PART No 24A4004 IN .15 HIGH CHARACTERS IN LOCATION SHOWN.
- VIBRA ETCH or ENGRAVE 'INNER S RIGHT' IN .2 CHARACTERS IN LOCATION SHOWN

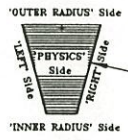

UNLESS OTHERWISE SPECIFIED		SHOP ORDERS		LAWRENCE BERKELEY LABORATORY			
X ± 1	FRACTION ± 1/64	ACT. IN	SERIAL NO.	UNIVERSITY OF CALIFORNIA-BERKELEY			
XX ± 0.2	ANGLES ± 1°	DATE	DATE	RHIC-STAR-TPC			
XXX ± 0.05	FINISH 125-7	ISSUE	REV	INNER SECTOR			
THREADS ARE CLASS 2		SURFACE TREATMENT		GATED GRID WIRE MOUNT, RIGHT			
CHAMFER ENDS OF ALL SCREW THREADS 30°		CLEAN AND OIL FREE		PATENT CLEAR			
USE 1/8 PITCH AND RELIEF WITH HOOK AND RELIEF		SEE NOTES		DWG TYPE			
ON MACHINING CUT THREADS		BY: J. BOEHR		00X0000			
BREAK EDGES 60° MAX. ON MACHINED WORK		DATE: 52-01-15		SCALE			
REMOVE BURRS WIRE BRASS & LOGS SCALE		BY: J. BEREDVITZ		FULL			
REFERENCES: ANSI Y14.5 & B46.1		DATE: 52-01-15		SIZE			
REV	DWG	CHK	ZONE	DATE	CHANGES	DESIGN	REV.
						8052-24	24A4004


REV	ITEM	PART NUMBER	DESCRIPTION
		24A4023	INNER SECTOR GATED GRID WIRE MOUNT EXTRUSION

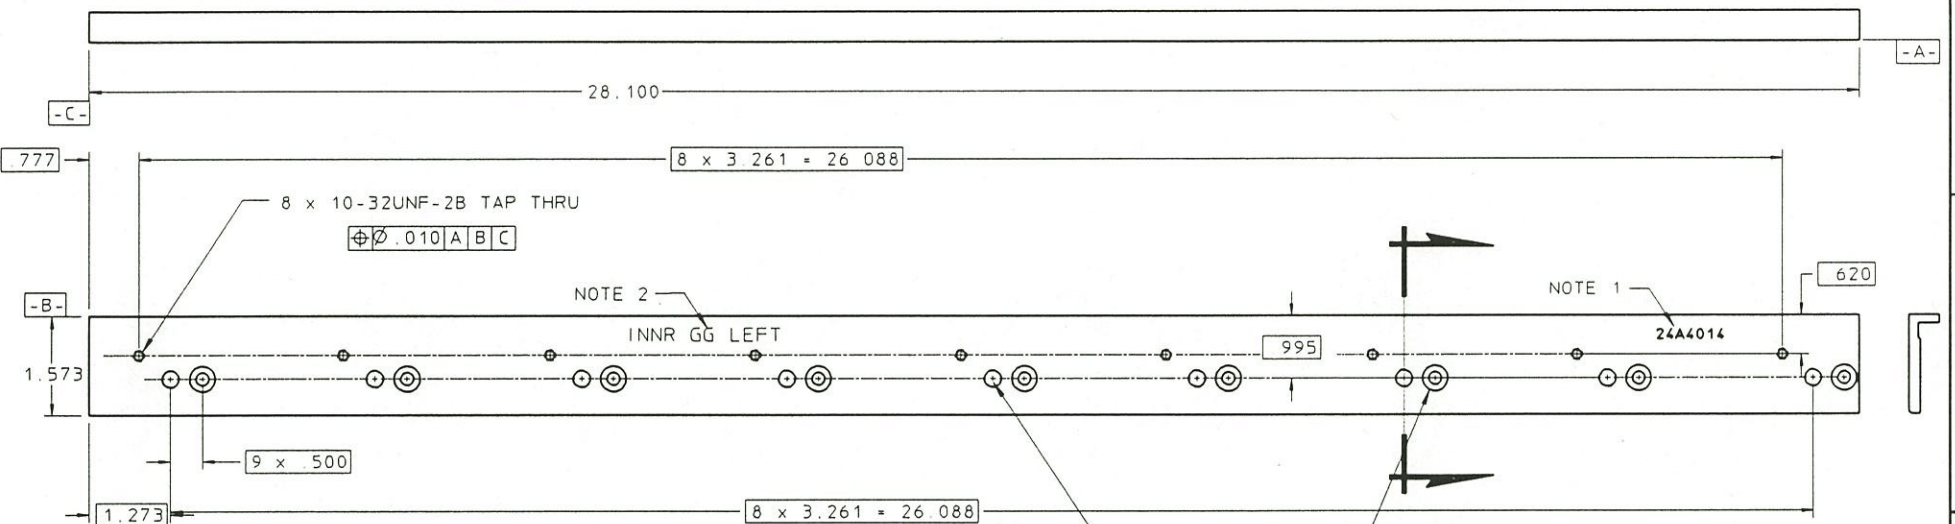

-B-	REF	D
002		
001		

NOTES


- VIBRA-ETCH or ENGRAVE PART No 24A4014 IN .15 HIGH CHARACTERS IN LOCATION SHOWN
- VIBRA ETCH or ENGRAVE 'INNER S LEFT' IN .2 CHARACTERS IN LOCATION SHOWN.

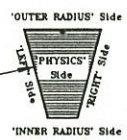


SECTION
SCALE 4:1

UNLESS OTHERWISE SPECIFIED				SHOP ORDERS				LAWRENCE BERKELEY LABORATORY			
X ± .1				FRAC. ± 1/64				UNIVERSITY OF CALIFORNIA-BERKELEY			
XX ± .02				ANGLES ± 1°				RHIC-STAR-TPC			
XXX ± .005				FINISH 125				INNER SECTOR			
TOLERANCES				SURFACE TREATMENT				GATED GRID WIRE MOUNT, LEFT			
THREADS ARE CLASS 2				CHAMFER ENDS OF ALL SCREW THREADS 30°				PATENT CLEAR			
ON MACHINE CUT THREADS				REMOVE BURRS AND SPALLS & LOGIC SCALE				Dwg. No. 00X0000			
REFERENCES: AWS 1 714.5 & 844.1				DATE 12-01-70				SCALE FULL			
REV				Dwg. No. 8052-24				SR-02-04			
CHK				DATE				REV.			
ZONE				CHANGES				24A4014			
DATE				DATE				DATE			

24A4032	RECD	ITEM	PART NUMBER	DESCRIPTION
		HIGH PRESSURE	EPOXY/GLASS LAMINATE, per FED SPEC's LP509a.	
		TYPE 4 GRADE	G-10 (DO NOT USE FR-4)	

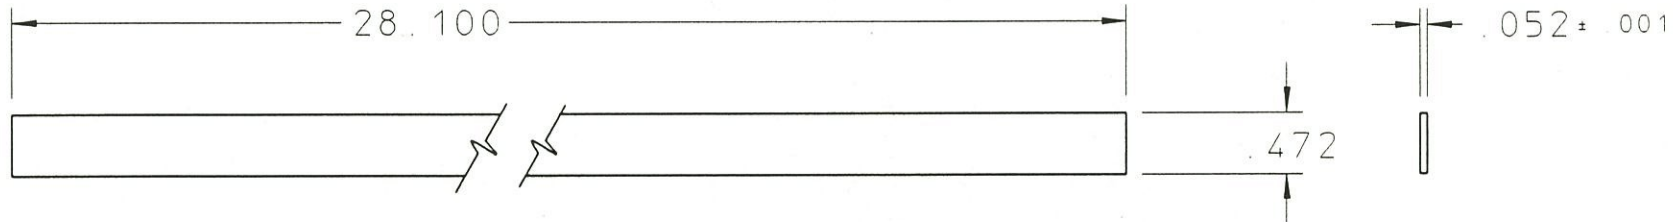

24A4032-2

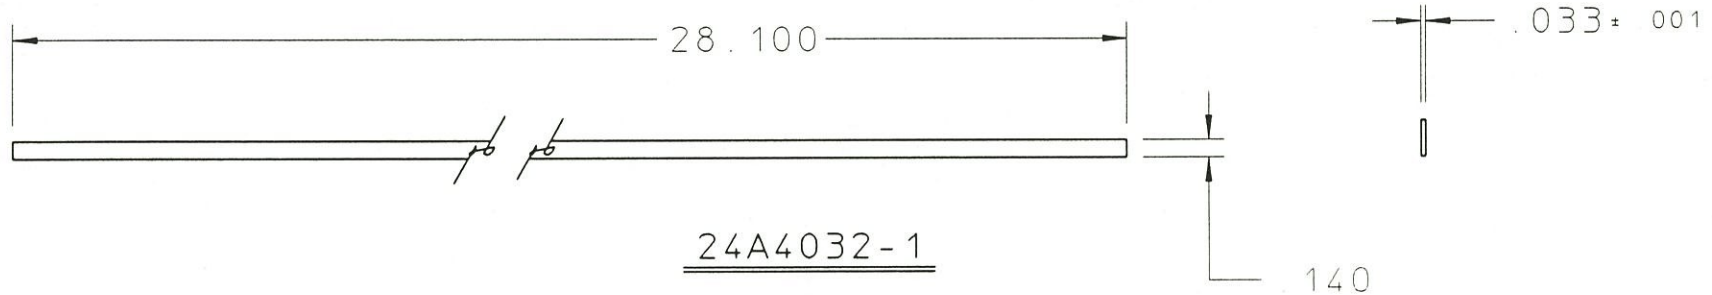

24A4032-1

				UNLESS OTHERWISE SPECIFIED			SHOP ORDERS			LAWRENCE BERKELEY LABORATORY												
				TOLERANCE X ± 1 .XX ± .02 XXX ± .005			ACCT NO		SER NO		UNIVERSITY OF CALIFORNIA-BERKELEY											
				SURFACE FINISH 125 ✓			DATE ISSD		DATE RECD		NO RECD		RHIC-STAR-TPC									
				1. SAWED, FLAMECUT. SHEARED OR CUT STOCK FINISH. 2. THREADS CLASS 2. 3. CHAMFER ENDS OF ALL SCREW THRS 30°. 4. 1 1/2 PITCH RELIEF WITH ROUND NOSE. TOOL ON ALL MACHINE CUT THRS. 5. BREAK EDGES 1/64 MAX. ON MACHINE WORK. 6. REMOVE BURRS, LOOSE SCALE AND WELD SPLATTER. 7. REF.-USASI OR ASA STDS SECT Y-14 & B46-1			DELIVER TO		SURFACE TREATMENT		INNER SECTOR											
							IDENTIFY		RINSE W/ALCOHOL		WIRE MOUNT INSULATING BOARD											
							METHOD		BAG & TAG		PAT CLEAR		DWG TYPE		SHOWN ON		SCALE: FULL					
							DWG BY		J BOEHM		DATE		DETAIL		24A0000		DO NOT SCALE PRINTS					
REV	DWN	CHK	DATE	DESCRIPTION			CHK BY		J BERCOVITZ		DATE		8052-24		SR-02-04		DWG NO		24A4032		REV	

*

PRINT LIST

TITLE: STAR TPC
INNER SECTOR ELECTRONICS
GATED GRID WIRE MOUNT BOARD
(PANEL OF 16 BOARDS)

FILE NO.: a000896p1 REV:
PRINT NO.: 24A4501 P-1
CHANGES (*)

ENGINEER: JIM HUNTER
DRAFTER: STIRKKINEN

DATE: 04/08/94
PAGE: 1 OF 1

<u>Drawing No.</u>	<u>Chg. Ltr.</u>	<u>Title</u>
24A4502 M-1 (a000896m1)		BOARD OUTLINE - SINGLE BOARD
24A4503 M-2 (a000896m2)		BOARD OUTLINE - PANEL OF 16
24A4502 E-1 (a000896e1)		HOLE SCHEDULE - SINGLE BOARD
24A4503 E-2 (a000896e2)		HOLE SCHEDULE - PANEL OF 16 (BLIND VIAS)
24A4503 E-3 (a000896e3)		HOLE SCHEDULE - PANEL OF 16
24A4501 U-1 (a000896u1)		ARTWORK - SINGLE BOARD LAYER 1 - WIRE MOUNT PADS LAYER 2 - PADS AND TRACES LAYER 3 - NO COPPER (BLANK) LAYER 4 - H.V. PADS
24A4501 U-2 (a000896u2)		ARTWORK - PANEL OF 16 24A4501 U-1'S

** THE FOLLOWING DRAWINGS NOT REQUIRED FOR THIS PACKAGE:
PARTS LIST, SILKSCREEN, PC BOARD ASSEMBLY

NUMBERS WITHIN () REFER TO EGS COMPUTER FILES

***** LBL BOARD A000896U2 *****
***** MAY 17, 1994 *****
***** WHEEL W896INFO *****

NEED 3 STANDARD PHOTOPLOTS, 3 POSITIVES AND 3 NEGATIVES.

FILM SIZE IS APPROXIMATELY 28.300 X 12.800 INCHES.

DELIVERY DATE: MAY 19, 1994 OR SOONER.

PHOTOPLOT FILES IN POSITIVE FORMAT:

PL896L1 - LAYER 1 SOLDER SIDE

PL896L2 - LAYER 2 PADS AND TRACES

- LAYER 3 (NO PLOT-BLANK LAYER)

PL896L4 - LAYER 4 H.V. PADS

PLEASE MAKE CONTACT COPIES OF PLOT FILES (3). I NEED ONE (1) POSITIVE
AND ONE (1) NEGATIVE OF EACH FILE, EMULSION DOWN, RIGHT READING.

THIS IS A TOTAL OF THREE (3) POSITIVES AND THREE (3) NEGATIVES.

PLEASE NOTE THIS USES THE SAME WHEEL AS JOB A000893U2.


IF THERE ARE ANY QUESTIONS OR PROBLEMS PLEASE CALL -JUDY- (916)

547-4005 OR -JIM- (510)486-7084.


REV.	CHANGES	DRAWN	DATE	CHKD.	DATE

LAYER FOUR VIEW

SCALE: NONE

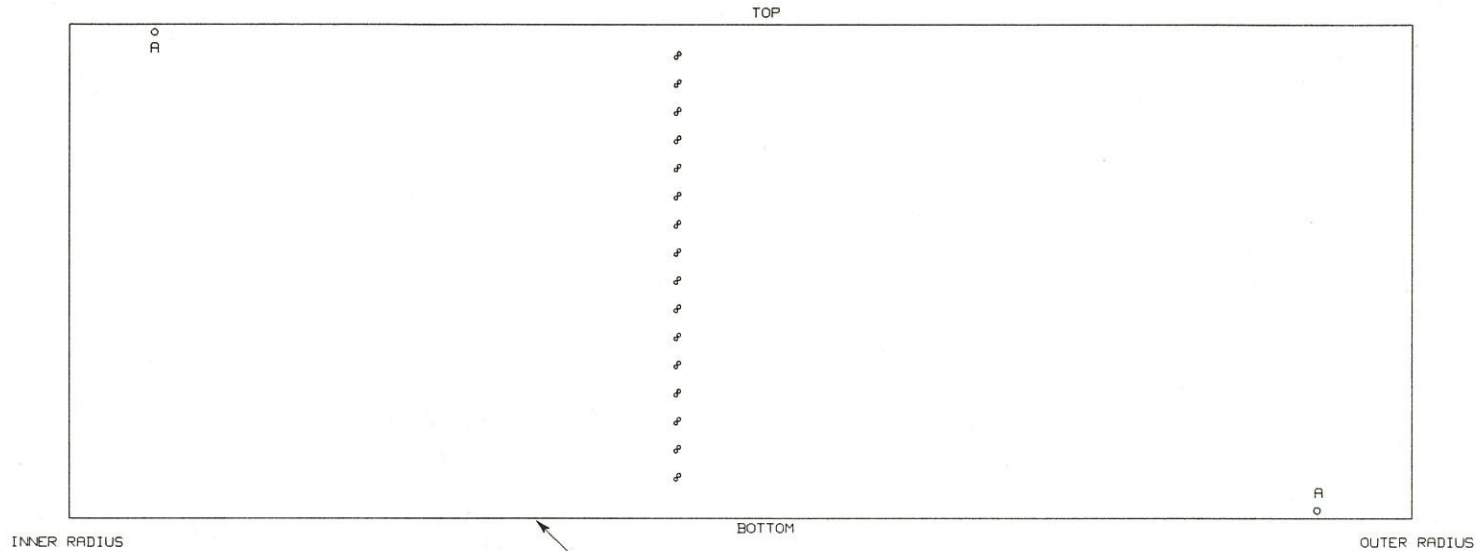

MANUFACTURER MAY PUT THEIR IDENTIFICATION NUMBER ON OUTER EDGES ONLY, TOP OR BOTTOM.

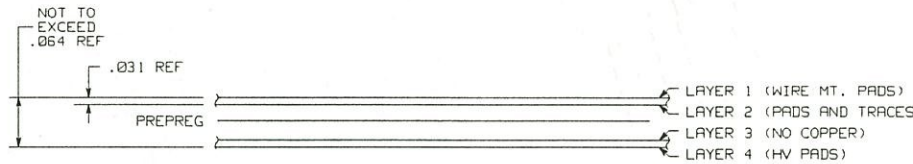

USE .015 DIA HOLE (5,440 HOLES)
THESE HOLES ONLY GO THROUGH
LAYERS 1 AND 2 (BLIND VIAS).
SEE DRAWING 24A4503 E-2.

USE .028 DIA HOLE (32 HOLES).
DRILL THESE HOLES AFTER ASSEMBLY
OF ALL LAYERS, SEE THIS DRAWING.

NOTES:


- BOARD MATERIAL: .031 THICK G10 PER MIL-P-55617 FL-GEN 031C-1/1-A1A (1 OZ. COPPER EACH SIDE). THIS IS A MULTILAYER BOARD (4 LAYERS). TOTAL THICKNESS NOT TO EXCEED .064.
- PLEASE NOTE THAT THERE IS NO COPPER ON LAYER 3.
- THIS BOARD TO BE THROUGH HOLE PLATED.
- SPECIFIED HOLE DIA. SIZES ARE FOR FINISHED HOLES AFTER PLATING.
- BOARD SIZE IS 10.500 +/- .010 X 28.100 +/- .005. DIMENSIONS ARE IN INCHES. BOARD OUTLINE DRAWING IS 24A4503 M-2 (a000896m2).
- SOLDERMASK IS NOT USED ON THIS BOARD.
- REFERENCE DRAWINGS:
 24A4502 M-1 a000896m1 BOARD OUTLINE - SINGLE BOARD
 24A4503 M-2 a000896m2 BOARD OUTLINE - PANEL OF 16
 24A4502 E-1 a000896e1 HOLE SCHEDULE - SINGLE BOARD
 24A4503 E-2 a000896e2 HOLE SCHEDULE - PANEL OF 16, BLIND VIAS

HOLE SCHEDULE		
CODE	HOLE DIA.	COUNT
NONE	.028	32
A	.125	2

D I S T		TITLE STAR TPC	
I I:		INNER SECTOR ELECTRONICS	
I I I:		GATED GRID WIRE MOUNT BOARD - PANEL 0F 16	
S-H-W-N		HOLE SCHEDULE - 24A4501 U-2 (A000896U2)	
ACCOUNT NUMBER	8052-24	DRAWN	DATE
SERIAL NUMBER		STIRAKKINEN	4/08/84
DATE ISSUED	NO. RECD.	CHECKED	DATE
DATE RECD.		APPROVED	DATE
DEL. TO	SCALE NONE	ENGINEER	JIM HUNTER
		FILE NO.	a000896e3
		SIZE	3
		DRAWING NO.	24A4503 E-3
		REV.	
		E14	
		SHEET 3 of 3	

REV.	CHANGES	DRAWN	DATE	CHKD.	DATE

LAYER ONE VIEW

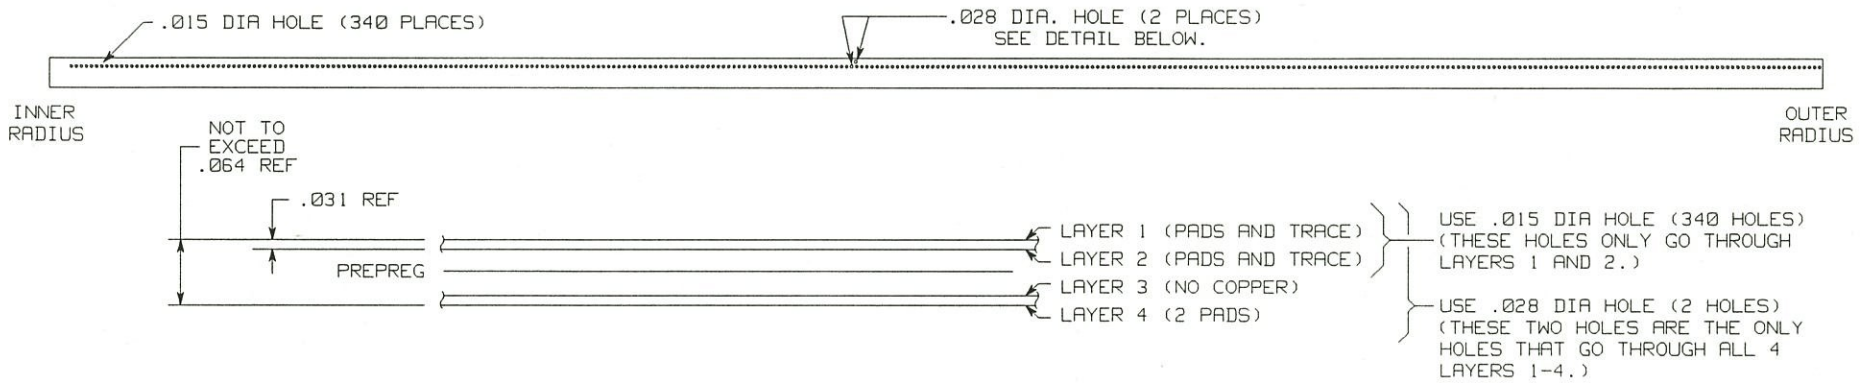

NOTES:

- BOARD MATERIAL: .031 THICK G10 PER MIL-P-55617 FL-GEN 031C-1/1-A1A (1 OZ. COPPER EACH SIDE). THIS IS A MULTILAYER BOARD (4 LAYERS). TOTAL THICKNESS NOT TO EXCEED .064.
- MANUFACTURER MAY NOT PUT ANY IDENTIFICATION NOMENCLATURE ON PRINTED CIRCUIT BOARD.
- PLEASE NOTE THAT THERE IS NO COPPER ON LAYER 3.
- THIS BOARD TO BE THROUGH HOLE PLATED. SEE DETAIL FOR BLIND VIAS (340 HOLES).
- SPECIFIED HOLE DIA. SIZES ARE FOR FINISHED HOLES AFTER PLATING.
- BOARD SIZE IS .472 +.000/-.010 X 28.100 +/- .005. DIMENSIONS ARE IN INCHES. BOARD OUTLINE DRAWING IS 24A4502 M-1 (a000896m1).
- SOLDERMASK IS NOT USED ON THIS BOARD.
- REFERENCE DRAWINGS:
 24A4502 M-1 a000896m1 BOARD OUTLINE - SINGLE BOARD
 24A4503 M-2 a000896m2 BOARD OUTLINE - PANEL OF 16
 24A4503 E-2 a000896e2 HOLE SCHEDULE - PANEL OF 16 (BLIND VIAS)
 24A4503 E-3 a000896e3 HOLE SCHEDULE - PANEL OF 16

D I S T		TITLE		STAR TPC	
I:		II:		INNER SECTOR ELECTRONICS	
III:		GATED GRID WIRE MOUNT BOARD - SINGLE BD.		HOLE SCHEDULE - 24A4501 U-1 (A000896U1)	
SHOWN ON		ACCOUNT NUMBER		DRAWN	
8052-24		STIRKKINEN		DATE 4/8/94	
SERIAL NUMBER		CHECKED		DATE	
DATE ISSUED		NO. RECD.		APPROVED	
DATE RECD.		ENGINEER		DATE	
DEL. TO		SCALE		NONE	
E2,C3		FILE NO.		SIZE	
a000896e1		2		DRAWING NO.	
24A4502 E-1		REV.			
SHEET 1 OF 3					

TITLE: STAR TPC
INNER SECTOR ELECTRONICS
GATED GRID WIRE MOUNT BOARD
(PANEL OF 16 BOARDS)

FILE NO.: a000896p1 REV:
PRINT NO.: 24A4501 P-1
CHANGES (*)

ENGINEER: JIM HUNTER
DRAFTER: STIRKKINEN

DATE: 04/08/94
PAGE: 1 OF 1

Drawing No.	Chg. Ltr.	Title
24A4502 M-1 (a000896m1)		BOARD OUTLINE - SINGLE BOARD
24A4503 M-2 (a000896m2)		BOARD OUTLINE - PANEL OF 16
24A4502 E-1 (a000896e1)		HOLE SCHEDULE - SINGLE BOARD
24A4503 E-2 (a000896e2)		HOLE SCHEDULE - PANEL OF 16 (BLIND VIAS)
24A4503 E-3 (a000896e3)		HOLE SCHEDULE - PANEL OF 16
24A4501 U-1 (a000896u1)		ARTWORK - SINGLE BOARD LAYER 1 - WIRE MOUNT PADS LAYER 2 - PADS AND TRACES LAYER 3 - NO COPPER (BLANK) LAYER 4 - H.V. PADS
24A4501 U-2 (a000896u2)		ARTWORK - PANEL OF 16 24A4501 U-1'S

** THE FOLLOWING DRAWINGS NOT REQUIRED FOR THIS PACKAGE:
PARTS LIST, SILKSCREEN, PC BOARD ASSEMBLY

NUMBERS WITHIN () REFER TO EGS COMPUTER FILES

REV.	CHANGES	DRAWN	DATE	CHK'D.	DATE

LAYER TWO VIEW

SCALE: NONE

TOP




BOTTOM

INNER RADIUS

MANUFACTURER MAY PUT THEIR IDENTIFICATION NUMBER ON OUTER EDGES ONLY, TOP OR BOTTOM.

OUTER RADIUS

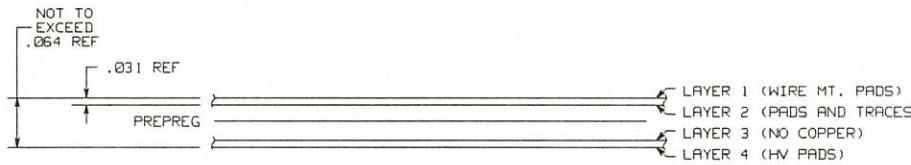

USE .015 DIA HOLE (5,440 HOLES)
THESE HOLES ONLY GO THROUGH
LAYERS 1 AND 2 (BLIND VIAS).
SEE THIS DRAWING.

USE .028 DIA HOLE (32 HOLES).
DRILL THESE HOLES AFTER ASSEMBLY
OF ALL LAYERS, SEE DRAWING
24A4503 E-3.

NOTES:


- BOARD MATERIAL: .031 THICK G10 PER MIL-P-55617 FL-GEN 031C-1/1-A1A (1 OZ. COPPER EACH SIDE). THIS IS A MULTILAYER BOARD (4 LAYERS). TOTAL THICKNESS NOT TO EXCEED .064.
- PLEASE NOTE THAT THERE IS NO COPPER ON LAYER 3.
- THIS BOARD TO BE THROUGH HOLE PLATED.
- SPECIFIED HOLE DIA. SIZES ARE FOR FINISHED HOLES AFTER PLATING.
- BOARD SIZE IS 10.500 +/- .010 X 28.100 +/- .005. DIMENSIONS ARE IN INCHES. BOARD OUTLINE DRAWING IS 24A4503 M-2 (a000896m2).
- SOLDERMASK IS NOT USED ON THIS BOARD.
- REFERENCE DRAWINGS:
24A4502 M-1 a000896m1 BOARD OUTLINE - SINGLE BOARD
24A4503 M-2 a000896m2 BOARD OUTLINE - PANEL OF 16
24A4502 E-1 a000896e1 HOLE SCHEDULE - SINGLE BOARD
24A4503 E-3 a000896e3 HOLE SCHEDULE - PANEL OF 16

HOLE SCHEDULE		
CODE	HOLE DIA.	COUNT
NONE	.015	5,440

D I S T	I:	TITLE STAR TPC						
	II:	INNER SECTOR ELECTRONICS						
	III:	GATED GRID WIRE MOUNT BOARD - PANEL OF 16						
S O U R C E	IV:	HOLE SCHEDULE - 24A4501 U-2 (BLIND VIAS)						
	DATE	NO. RECD.	APPROVED	DATE	FILE NO.	SIZE	DRAWING NO.	REV.
ACCOUNT NUMBER	8052-24	DRAWN	STIRKINEN	DATE	4/28/84	LAWRENCE BERKELEY LABORATORY		
SERIAL NUMBER		CHECKED		DATE		UNIVERSITY OF CALIFORNIA		
DATE ISSUED		APPROVED		DATE		OFFICE OF ELECTRONICS ENGINEERING		
DATE RECD.		ENGINEER	JIM HUNTER		a000896e2	3	24A4503 E-2	
DEL. TO		SCALE	NONE		C8, E14		SHEET 2 of 3	


27765 342
49'

$$\begin{array}{r} 82 \overline{) 27716} \quad 339 \\ \underline{246} \\ 311 \\ \underline{246} \\ 756 \\ \underline{738} \\ 16 \end{array} \quad \begin{array}{r} 339 \\ \hline 16 \\ \hline 82 \end{array} = \frac{8}{41}$$

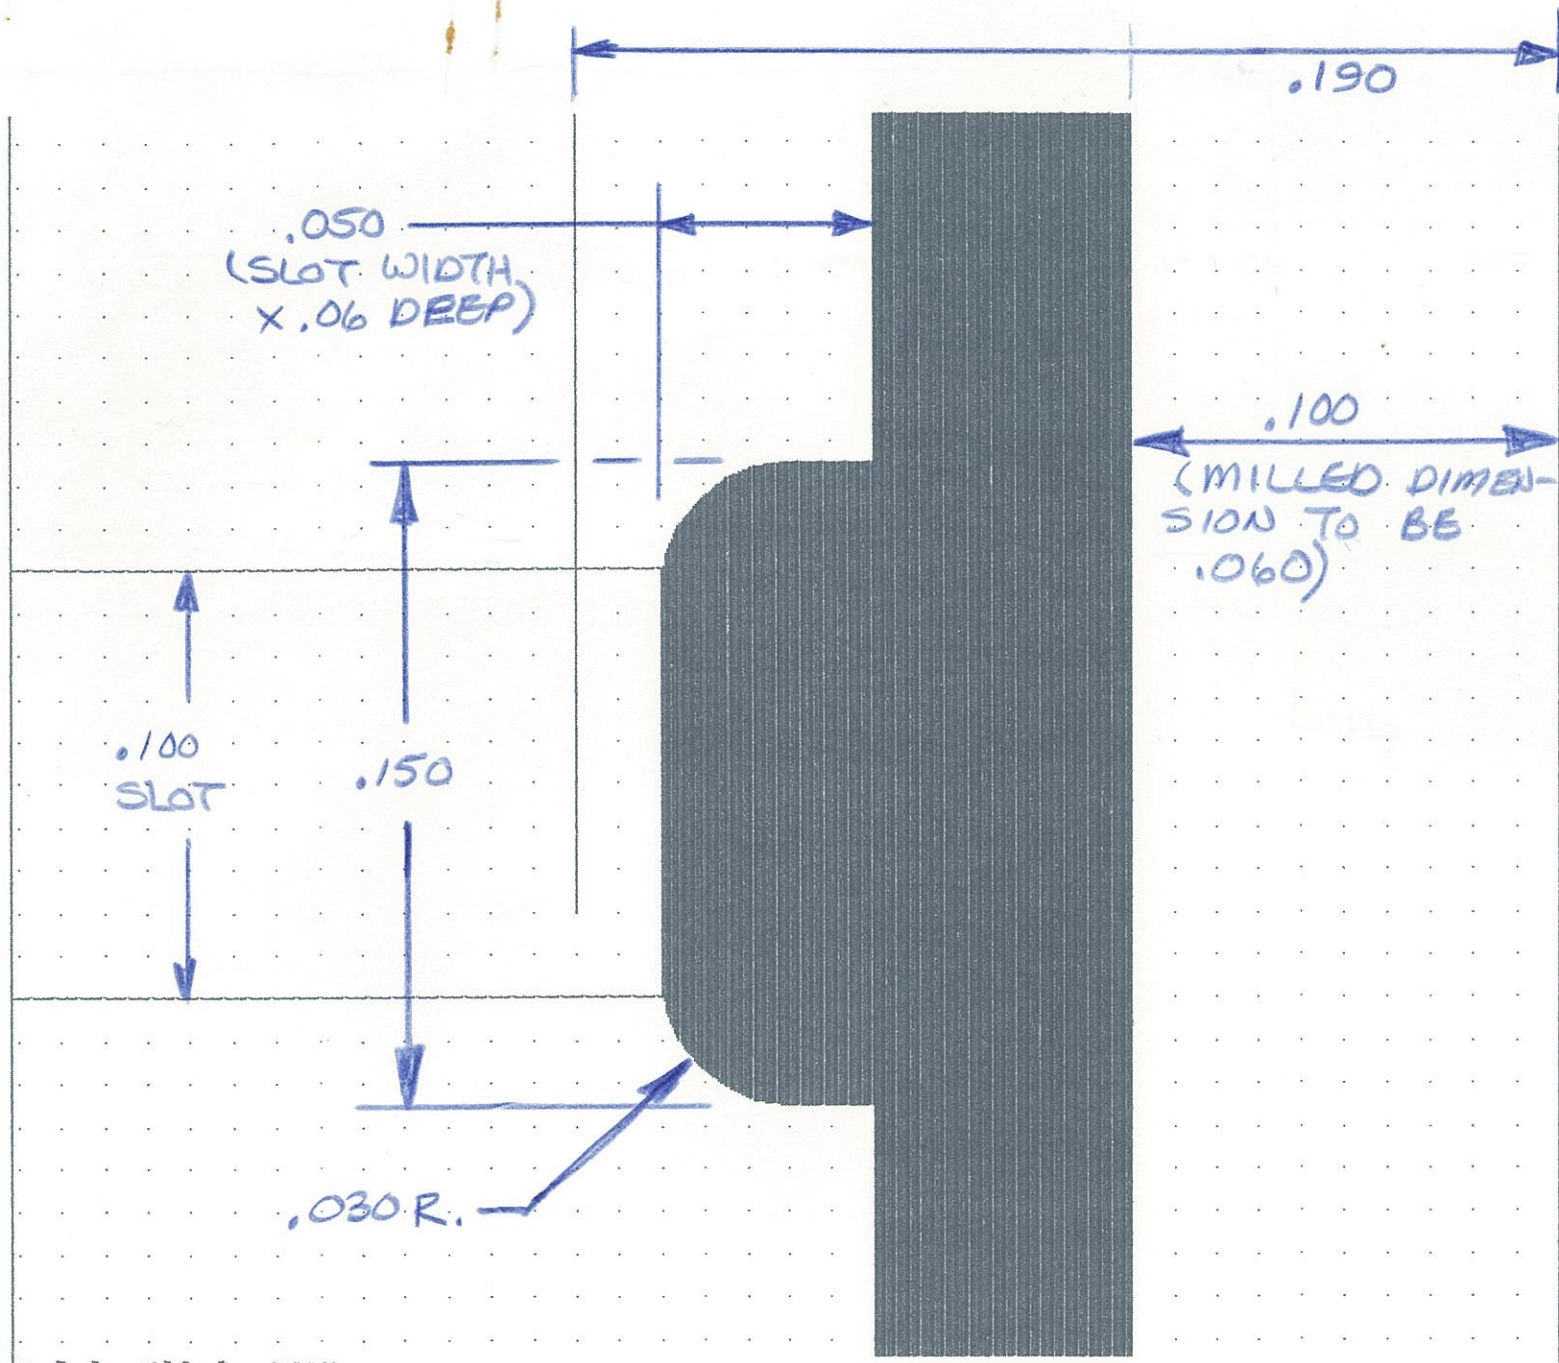

G:5 2 :X28.9 :GRID



171 -9000

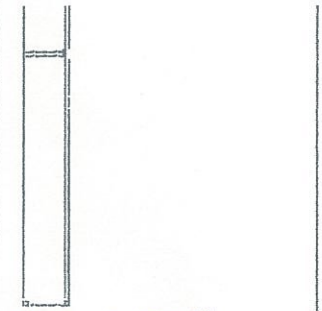

1.50"

\$GR	\$VR	\$IN	\$P	\$R
Edit	FCB	Make	Prt	
Layer	5	BK	UNDO*	
ADD*		DELETE*		
MODIFY*		STRETCH*		
MOVE*		GATHER*		
COPY*		STEP*		
WRAP*		SMASH*		
ROUTE*		MODNOTE*		
~Line		~Polygon		
~Rectang		~Hatch		
~Arcs		~Circle		
~Note		~Text		
~Part		~Net_Nam		
*FILL	*WDTH	*EDIT		
*LAYR	*FONT	*SLNT		
*SCAL	*ROT	*MIR		
ENT	0	1	2	3
ROC	5	6	7	8
INFO*	HELP*	OUT*		
RULE*	WIND*	SHOW*		
PLOT*	DUMP*	SAVE*		

$\frac{956}{871}$
 .178

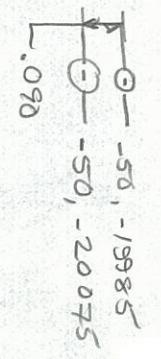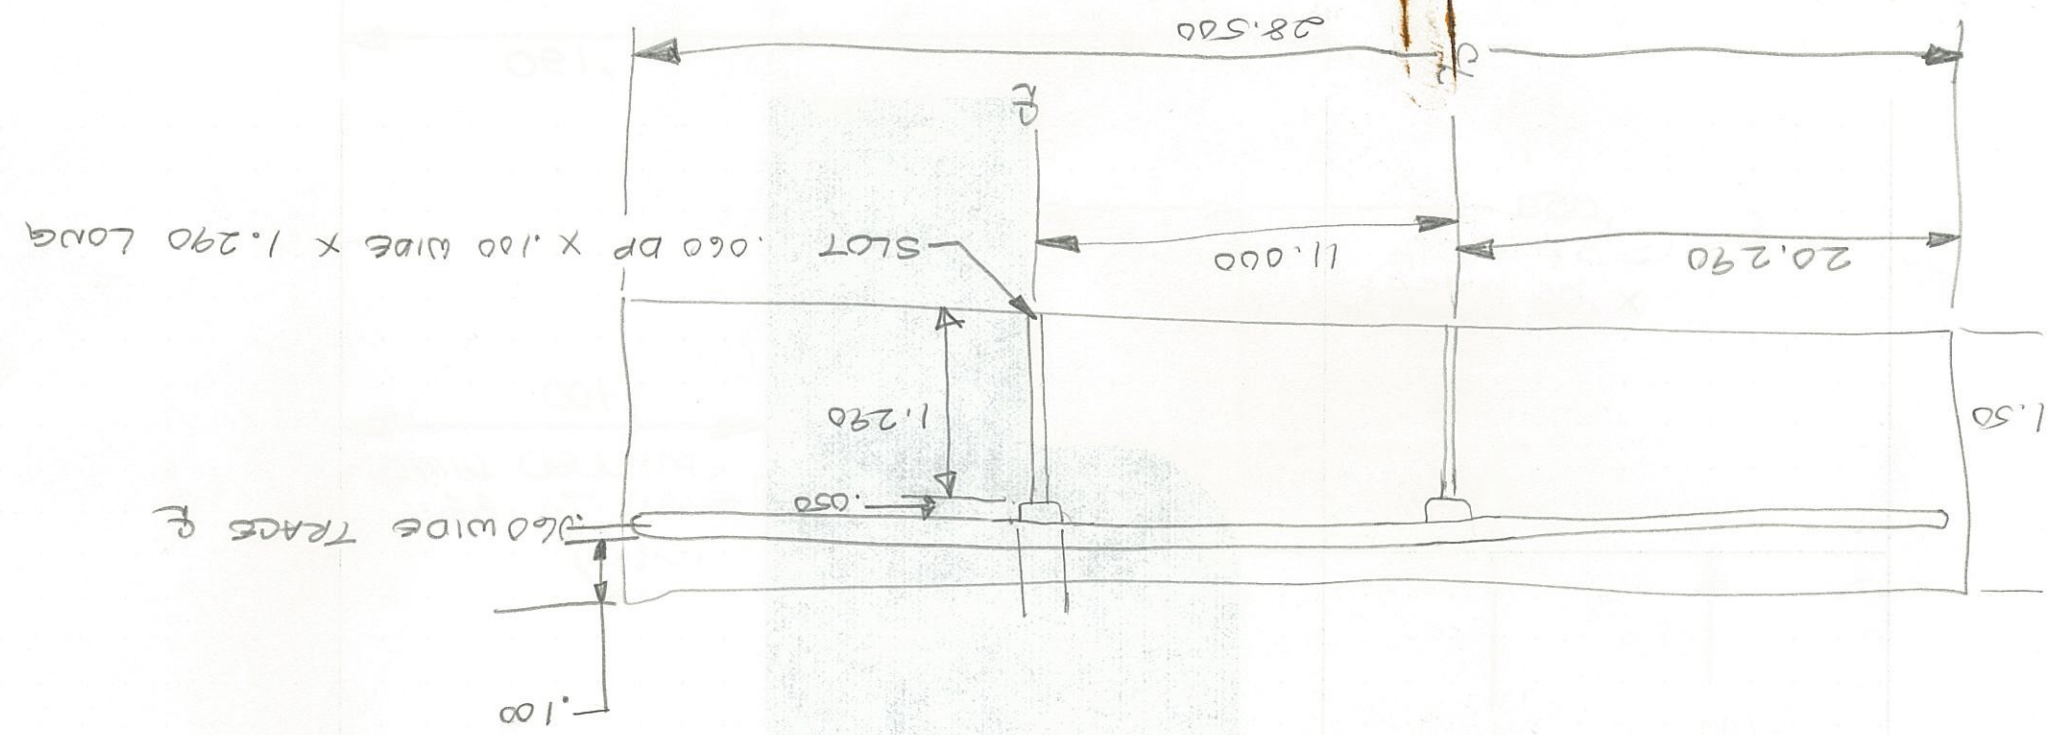

PLOT DUMP* SAVE*	
RULE WIND* SHOW*	
INFO HELP* OUT*	
BOC 2 1 8 1 1	
ENT 1 2 1 1 1	
SCALE NOT* NIB*	
LAYER FONT* FONT*	
FILE WITH* EDIT*	
PART -NOT* NAME*	
NAME -TEXT*	
ARCS -CLIP*	
POINT AND* -HATCH*	
LINE -WID*	
HATCH -WID*	
WAVE -WID*	
COPY -WID*	
TEXT -WID*	

171 -8000

DATE: 9.25.85