



ITEM	REV	PART NUMBER	DESCRIPTION
		24A4023	INNER SECTOR GATED GRID WIRE MOUNT EXTRUSION

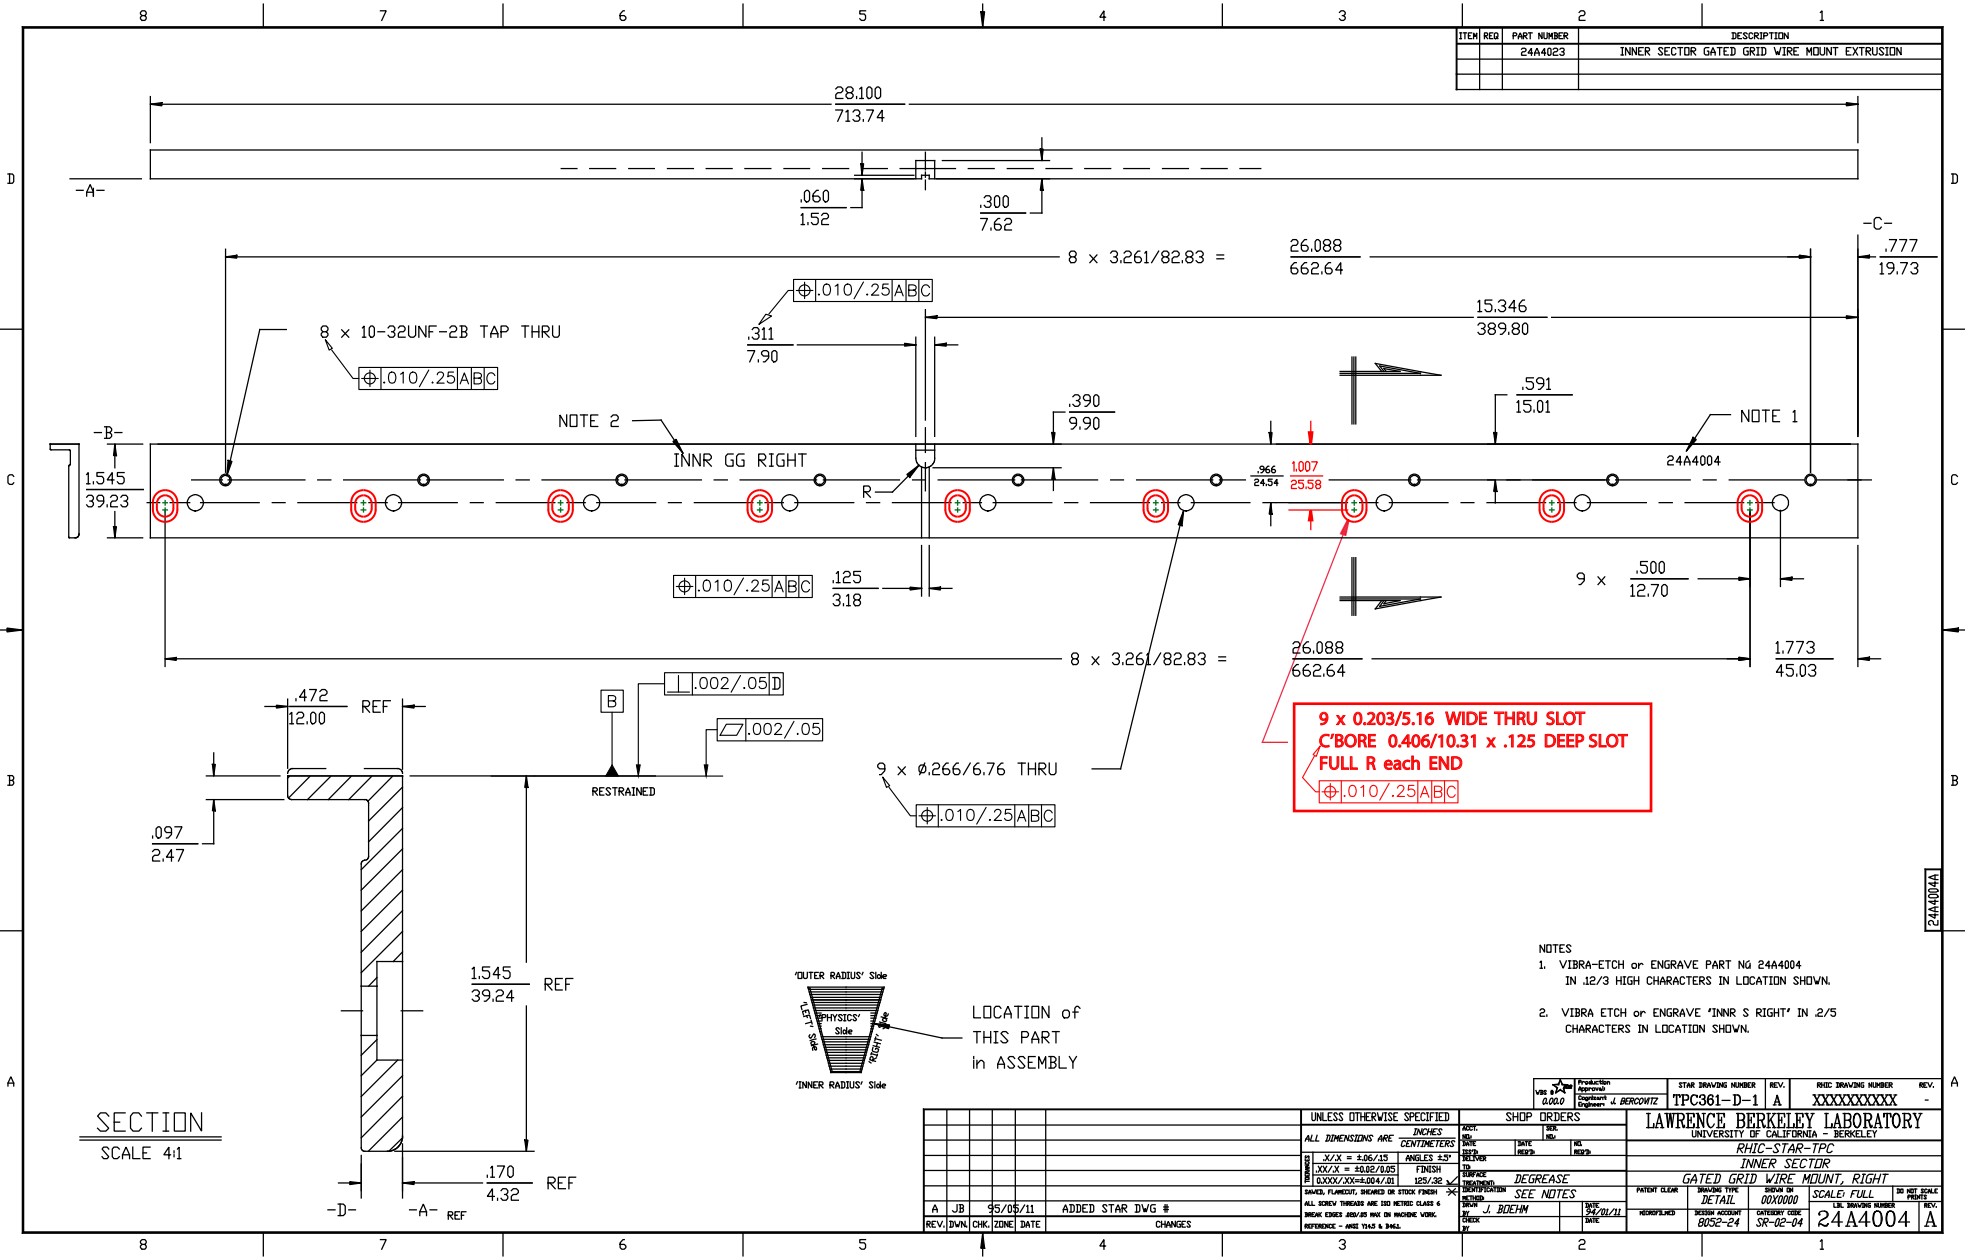

9 x 0.203/5.16 WIDE THRU SLOT
 C'BORE 0.406/10.31 x .125 DEEP SLOT
 FULL R each END
 ⌀.010/.25|A|B|C

- NOTES
- VIBRA-ETCH or ENGRAVE PART NG 24A4004 IN .12/3 HIGH CHARACTERS IN LOCATION SHOWN.
 - VIBRA ETCH or ENGRAVE 'INNER S RIGHT' IN 2/5 CHARACTERS IN LOCATION SHOWN.

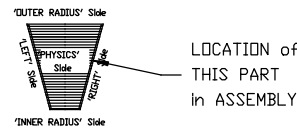

SECTION
SCALE 4:1

REV.	DATE	BY	CHK.	ZONE	DATE	CHANGES
A	95/05/11	JB				ADDED STAR DWG #

UNLESS OTHERWISE SPECIFIED	SHOP ORDERS	STAR DRAWING NUMBER	REV.	RHIC DRAWING NUMBER	REV.
ALL DIMENSIONS ARE INCHES	DATE	TPC361-D-1	A	XXXXXXXXXX	-
1/16" = 2.54/63.5	REV.	LAWRENCE BERKELEY LABORATORY			
1/32" = 0.03125/0.79375	DATE	UNIVERSITY OF CALIFORNIA - BERKELEY			
3/16" = 0.1875/4.7625	REV.	RHIC-STAR-TPC			
1/8" = 0.125/3.175	DATE	INNER SECTOR			
1/4" = 0.25/6.35	REV.	GATED GRID WIRE MOUNT, RIGHT			
3/8" = 0.375/9.525	DATE	SCALE: FULL			
1/2" = 0.5/12.7	REV.	SCALE: DETAIL			
3/4" = 0.75/19.05	DATE	SCALE: 2X			
1" = 25.4/635	REV.	SCALE: 4X			
1 1/4" = 31.75/806.25	DATE	SCALE: 8X			
1 1/2" = 38.1/965.25	REV.	SCALE: 12X			
2" = 50.8/1280	DATE	SCALE: 16X			
2 1/2" = 63.5/1600	REV.	SCALE: 20X			
3" = 76.2/1930	DATE	SCALE: 24X			
3 1/2" = 88.9/2250	REV.	SCALE: 28X			
4" = 101.6/2550	DATE	SCALE: 32X			
4 1/2" = 114.3/2900	REV.	SCALE: 36X			
5" = 127/3175	DATE	SCALE: 40X			
5 1/2" = 140/3650	REV.	SCALE: 44X			
6" = 152.4/3900	DATE	SCALE: 48X			
6 1/2" = 165.1/4190	REV.	SCALE: 52X			
7" = 177.8/4475	DATE	SCALE: 56X			
7 1/2" = 190.5/4800	REV.	SCALE: 60X			
8" = 203.2/5100	DATE	SCALE: 64X			
8 1/2" = 215.9/5450	REV.	SCALE: 68X			
9" = 228.6/5775	DATE	SCALE: 72X			
9 1/2" = 241.3/6100	REV.	SCALE: 76X			
10" = 254/6350	DATE	SCALE: 80X			
10 1/2" = 266.7/6700	REV.	SCALE: 84X			
11" = 279.4/7050	DATE	SCALE: 88X			
11 1/2" = 292.1/7375	REV.	SCALE: 92X			
12" = 304.8/7650	DATE	SCALE: 96X			
12 1/2" = 317.5/8000	REV.	SCALE: 100X			
13" = 330.2/8325	DATE	SCALE: 104X			
13 1/2" = 342.9/8675	REV.	SCALE: 108X			
14" = 355.6/9000	DATE	SCALE: 112X			
14 1/2" = 368.3/9325	REV.	SCALE: 116X			
15" = 381/9600	DATE	SCALE: 120X			
15 1/2" = 393.7/9950	REV.	SCALE: 124X			
16" = 406.4/10200	DATE	SCALE: 128X			
16 1/2" = 419.1/10550	REV.	SCALE: 132X			
17" = 431.8/10875	DATE	SCALE: 136X			
17 1/2" = 444.5/11200	REV.	SCALE: 140X			
18" = 457.2/11500	DATE	SCALE: 144X			
18 1/2" = 469.9/11850	REV.	SCALE: 148X			
19" = 482.6/12150	DATE	SCALE: 152X			
19 1/2" = 495.3/12500	REV.	SCALE: 156X			
20" = 508/12750	DATE	SCALE: 160X			
20 1/2" = 520.7/13100	REV.	SCALE: 164X			
21" = 533.4/13375	DATE	SCALE: 168X			
21 1/2" = 546.1/13725	REV.	SCALE: 172X			
22" = 558.8/14000	DATE	SCALE: 176X			
22 1/2" = 571.5/14350	REV.	SCALE: 180X			
23" = 584.2/14625	DATE	SCALE: 184X			
23 1/2" = 596.9/14975	REV.	SCALE: 188X			
24" = 609.6/15250	DATE	SCALE: 192X			
24 1/2" = 622.3/15600	REV.	SCALE: 196X			
25" = 635/15875	DATE	SCALE: 200X			
25 1/2" = 647.7/16225	REV.	SCALE: 204X			
26" = 660.4/16500	DATE	SCALE: 208X			
26 1/2" = 673.1/16850	REV.	SCALE: 212X			
27" = 685.8/17125	DATE	SCALE: 216X			
27 1/2" = 698.5/17475	REV.	SCALE: 220X			
28" = 711.2/17750	DATE	SCALE: 224X			
28 1/2" = 723.9/18100	REV.	SCALE: 228X			
29" = 736.6/18375	DATE	SCALE: 232X			
29 1/2" = 749.3/18725	REV.	SCALE: 236X			
30" = 762/19000	DATE	SCALE: 240X			
30 1/2" = 774.7/19350	REV.	SCALE: 244X			
31" = 787.4/19625	DATE	SCALE: 248X			
31 1/2" = 799.9/20000	REV.	SCALE: 252X			
32" = 812.6/20275	DATE	SCALE: 256X			
32 1/2" = 825.3/20625	REV.	SCALE: 260X			
33" = 838/20900	DATE	SCALE: 264X			
33 1/2" = 850.7/21250	REV.	SCALE: 268X			
34" = 863.4/21525	DATE	SCALE: 272X			
34 1/2" = 876.1/21875	REV.	SCALE: 276X			
35" = 888.8/22150	DATE	SCALE: 280X			
35 1/2" = 901.5/22500	REV.	SCALE: 284X			
36" = 914.2/22775	DATE	SCALE: 288X			
36 1/2" = 926.9/23125	REV.	SCALE: 292X			
37" = 939.6/23400	DATE	SCALE: 296X			
37 1/2" = 952.3/23750	REV.	SCALE: 300X			
38" = 965/24025	DATE	SCALE: 304X			
38 1/2" = 977.7/24375	REV.	SCALE: 308X			
39" = 990.4/24650	DATE	SCALE: 312X			
39 1/2" = 1003.1/25000	REV.	SCALE: 316X			
40" = 1015.8/25275	DATE	SCALE: 320X			
40 1/2" = 1028.5/25625	REV.	SCALE: 324X			
41" = 1041.2/25900	DATE	SCALE: 328X			
41 1/2" = 1053.9/26250	REV.	SCALE: 332X			
42" = 1066.6/26525	DATE	SCALE: 336X			
42 1/2" = 1079.3/26875	REV.	SCALE: 340X			
43" = 1092/27150	DATE	SCALE: 344X			
43 1/2" = 1104.7/27500	REV.	SCALE: 348X			
44" = 1117.4/27775	DATE	SCALE: 352X			
44 1/2" = 1130.1/28125	REV.	SCALE: 356X			
45" = 1142.8/28400	DATE	SCALE: 360X			
45 1/2" = 1155.5/28750	REV.	SCALE: 364X			
46" = 1168.2/29025	DATE	SCALE: 368X			
46 1/2" = 1180.9/29375	REV.	SCALE: 372X			
47" = 1193.6/29650	DATE	SCALE: 376X			
47 1/2" = 1206.3/30000	REV.	SCALE: 380X			
48" = 1219/29975	DATE	SCALE: 384X			
48 1/2" = 1231.7/30325	REV.	SCALE: 388X			
49" = 1244.4/30600	DATE	SCALE: 392X			
49 1/2" = 1257.1/30950	REV.	SCALE: 396X			
50" = 1269.8/31225	DATE	SCALE: 400X			