



ITEM	REV	PART NUMBER	DESCRIPTION
		24A4023	INNER SECTOR GATED GRID WIRE MOUNT EXTRUSION

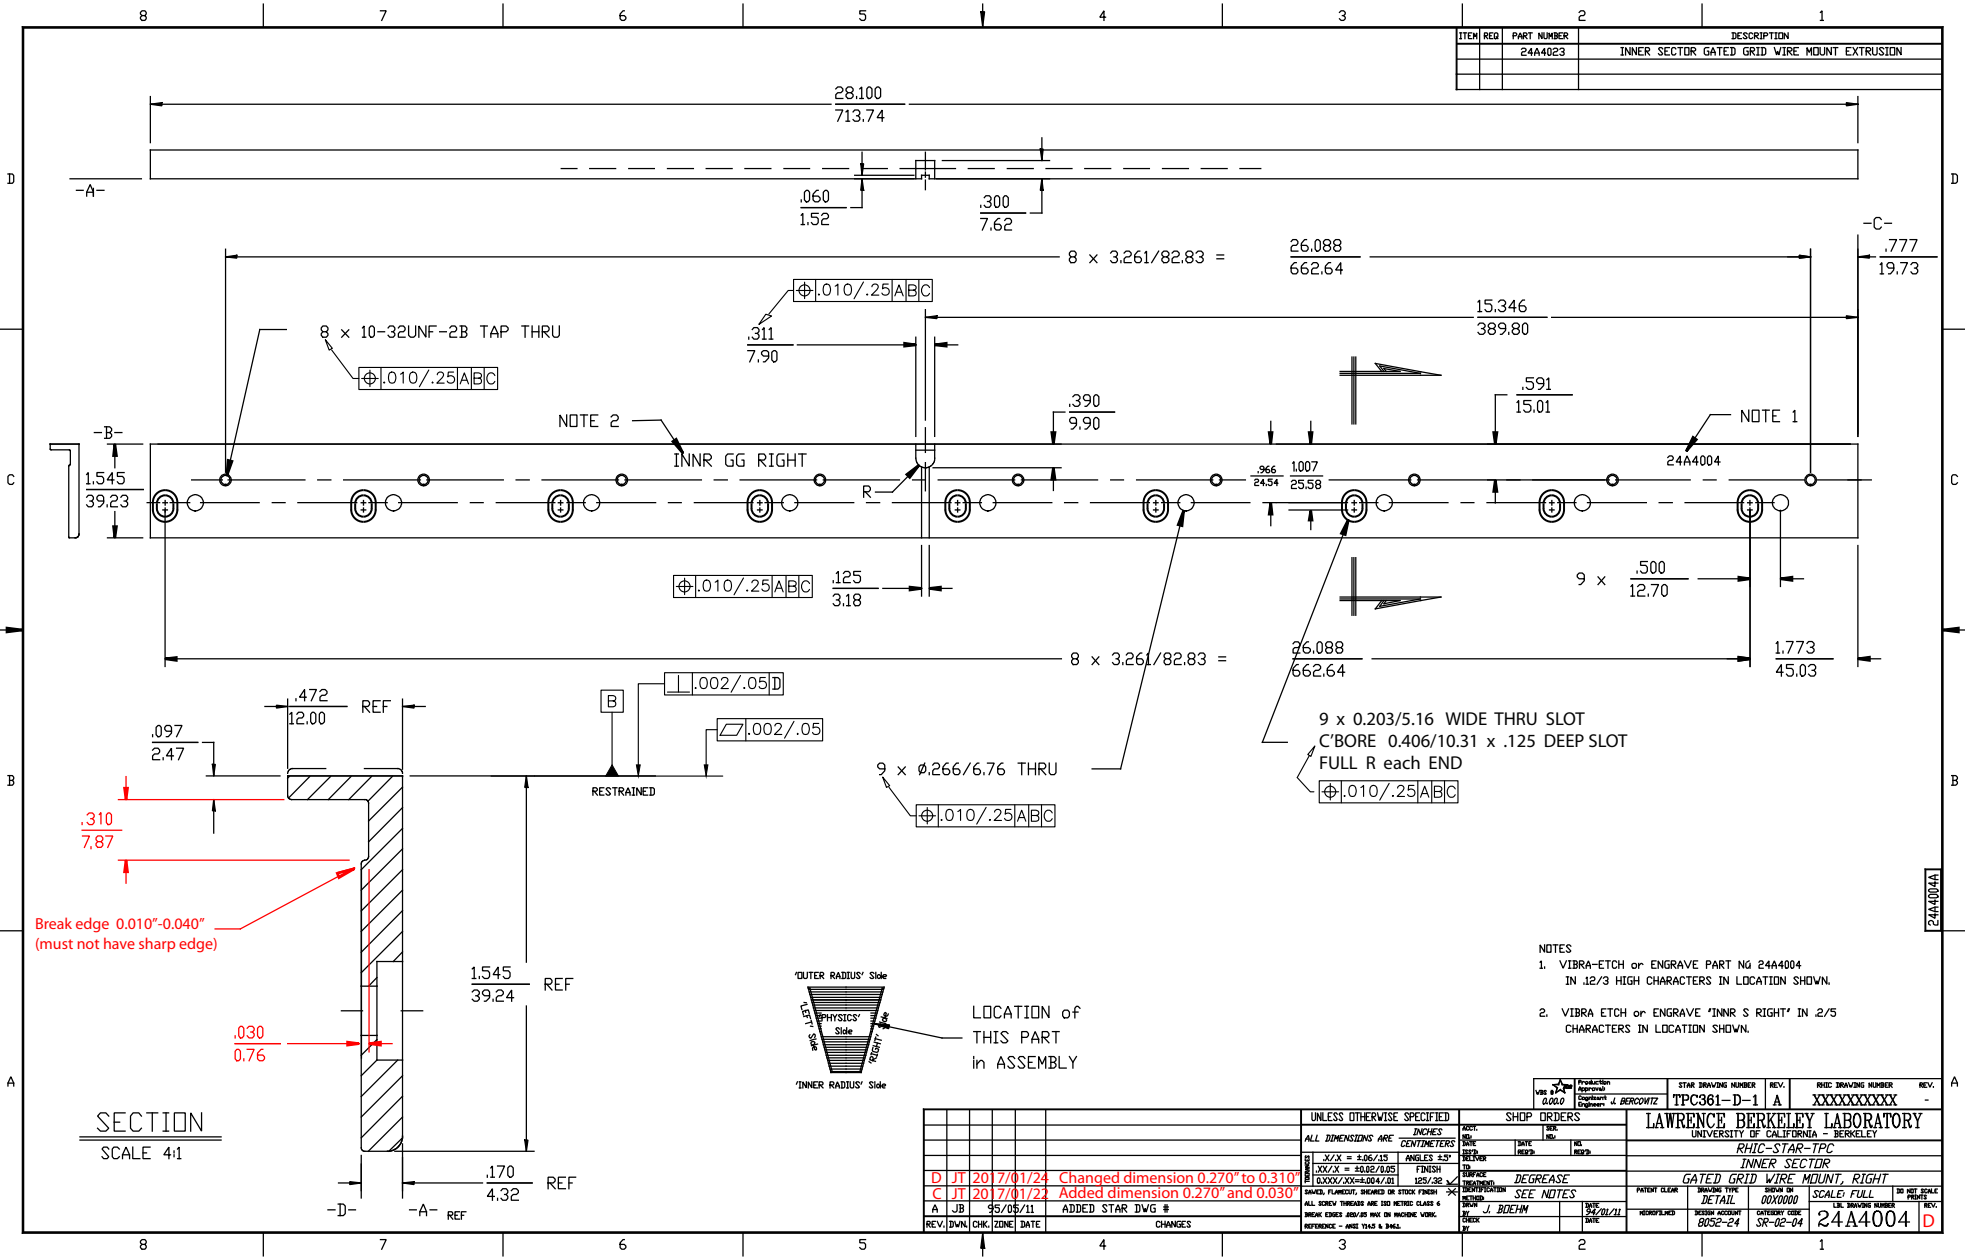

- NOTES
- VIBRA-ETCH or ENGRAVE PART NG 24A4004 IN .12/3 HIGH CHARACTERS IN LOCATION SHOWN.
  - VIBRA ETCH or ENGRAVE 'INNER S RIGHT' IN 2/5 CHARACTERS IN LOCATION SHOWN.

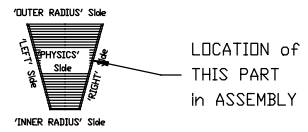

SECTION  
SCALE 4:1

REV.	DATE	CHK.	ZONE	DATE	CHANGES	UNLESS OTHERWISE SPECIFIED	SHOP ORDERS	STAR DRAWING NUMBER	REV.	RHIC DRAWING NUMBER	REV.
D	JT	2017/01/24			Changed dimension 0.270" to 0.310"	ALL DIMENSIONS ARE INCHES CENTIMETERS	NOT: DATE: ASK: RECD:	TPC361-D-1	A	XXXXXXXXXX	-
C	JT	2017/01/22			Added dimension 0.270" and 0.030"	FINISH: 125/32	DEGREASE	LAWRENCE BERKELEY LABORATORY			
A	JB	95/05/11			ADDED STAR DWG #	DRUGS, FLUORENT, BLENDED IN STEEL FINISH	SEE NOTES	UNIVERSITY OF CALIFORNIA - BERKELEY			
						ALL DIMENSIONS ARE TO HOLE CLASS 4		RHIC-STAR-TPC			
						BREAK EDGES 200/30 INK OR MODER VORSE		INNER SECTOR			
						REFERENCE - ASME Y14.5 & B96.		GATED GRID WIRE MOUNT, RIGHT			
								SCALE: FULL			
								00X0000			
								6052-24			
								SR-02-04			
								24A4004			