


ITEM	REV	PART NUMBER	DESCRIPTION
		24A4023	INNER SECTOR GATED GRID WIRE MOUNT EXTRUSION

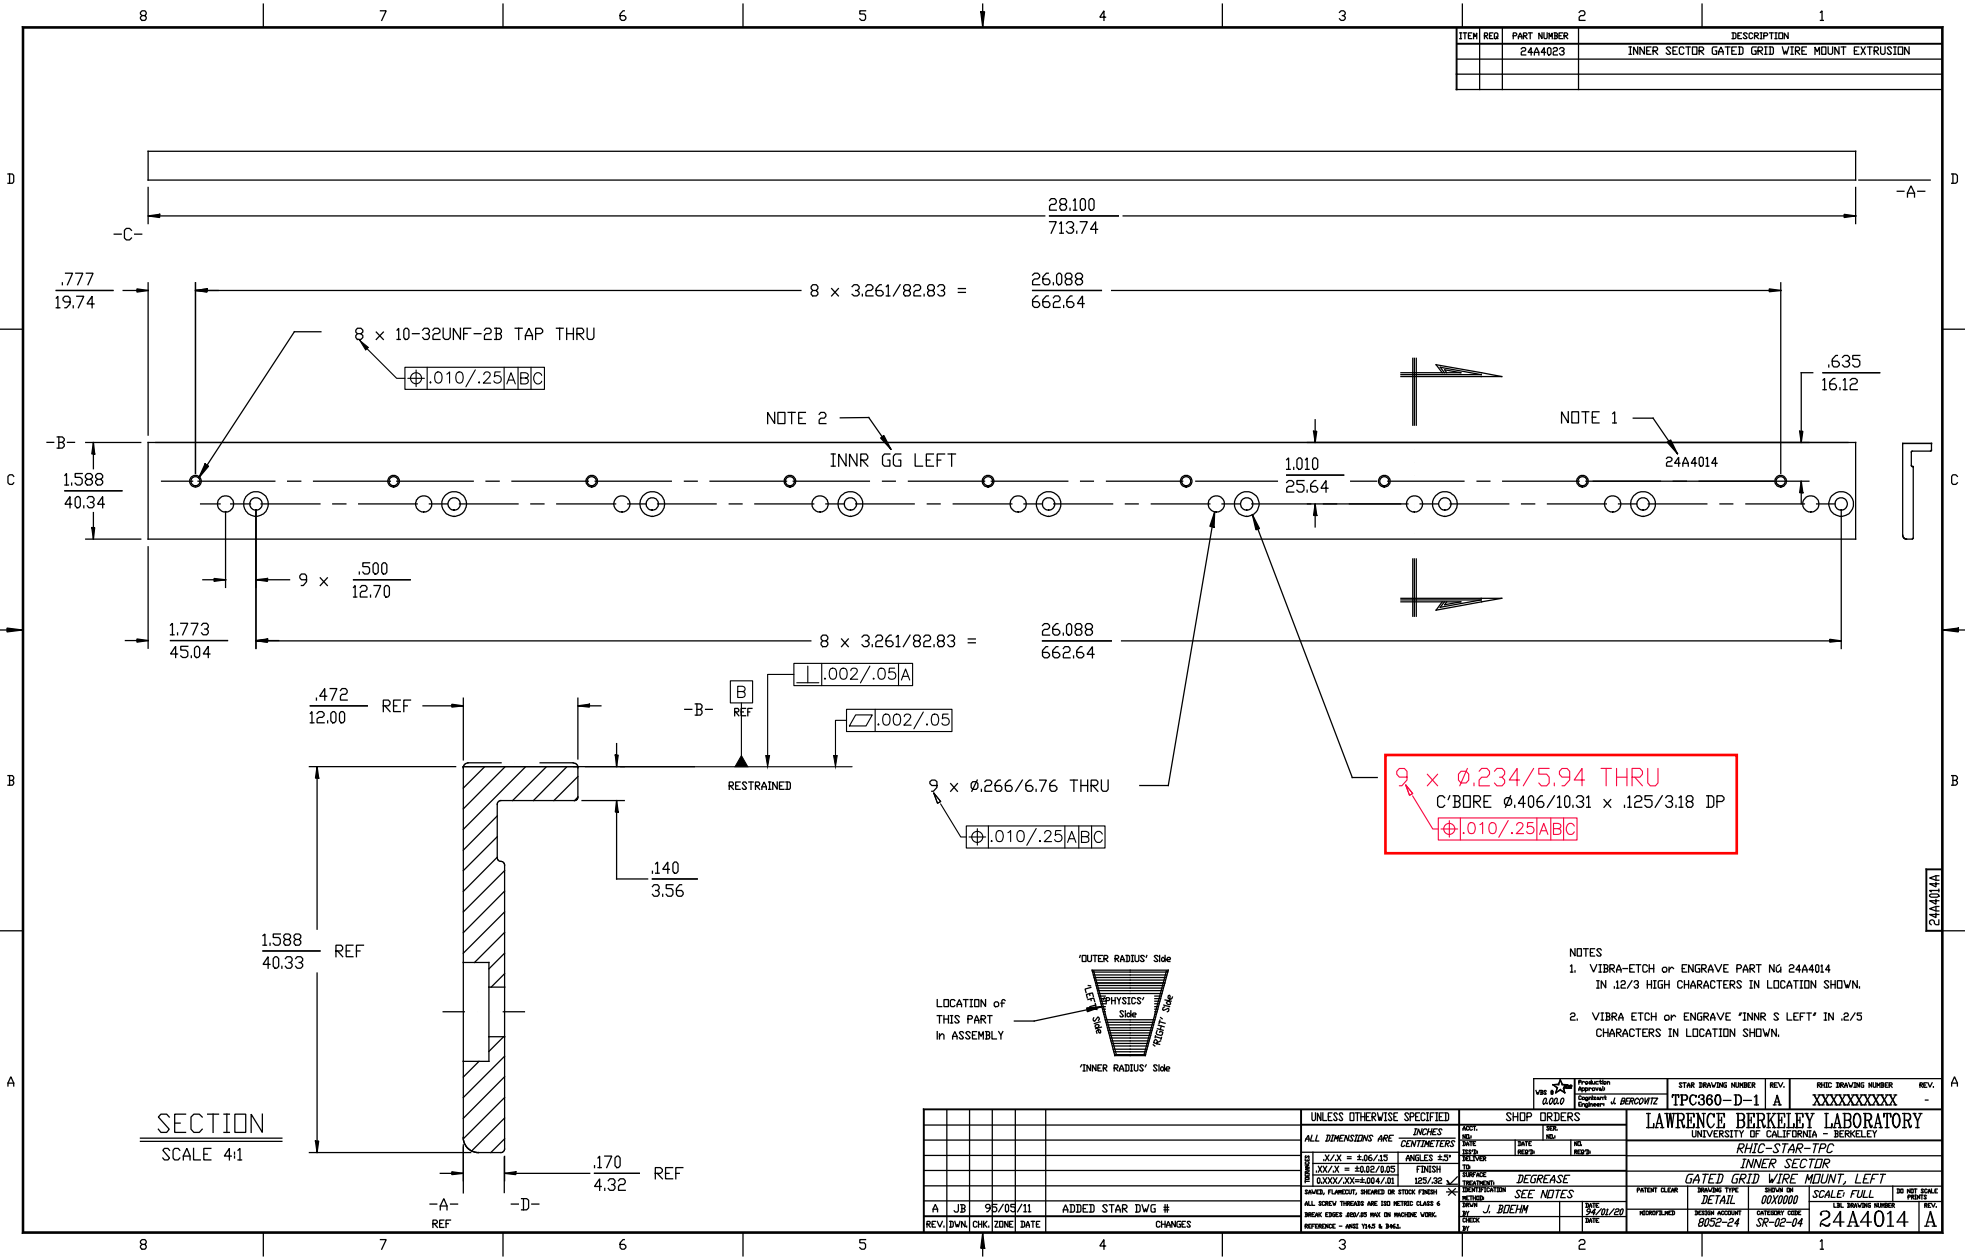

9 x ϕ .234/5.94 THRU
 C'BORE ϕ .406/10.31 x .125/3.18 DP
 ϕ .010/.25|A|B|C

- NOTES
- VIBRA-ETCH or ENGRAVE PART NG 24A4014 IN .12/3 HIGH CHARACTERS IN LOCATION SHOWN.
 - VIBRA ETCH or ENGRAVE 'INNER S LEFT' IN .2/5 CHARACTERS IN LOCATION SHOWN.

REV	APP	CHK	DATE	CHANGES
A	JB		95/05/11	ADDED STAR DWG #

PRODUCTION APPROVED	0.000	ENGINEER	J. BERKOWITZ
STAR DRAWING NUMBER	TPC360-D-1	REV.	A
RHIC DRAWING NUMBER	XXXXXXXXXX	REV.	-

LAWRENCE BERKELEY LABORATORY	
UNIVERSITY OF CALIFORNIA - BERKELEY	
RHIC-STAR-TPC	
INNER SECTOR	
GATED GRID WIRE MOUNT, LEFT	
PATENT CLEAR	SCALE FULL
DRAWING TYPE	SCALE FULL
DETAIL	SCALE FULL
ISSUE NO.	000000
ISSUE DATE	95/01/20
ISSUE BY	J. BOEHM
ISSUE DATE	95/01/20
ISSUE BY	J. BOEHM

24A4014A