ITEM	REQ	PART NUMBER	DESCRIPTION
			HIGH PRESSURE EPOXY/GLASS WEAVE LAMINATE, per FED SPECs
		LP509a	TYPE 4 GRADE G-10 (NOT FR-4) SEE NOTE 3

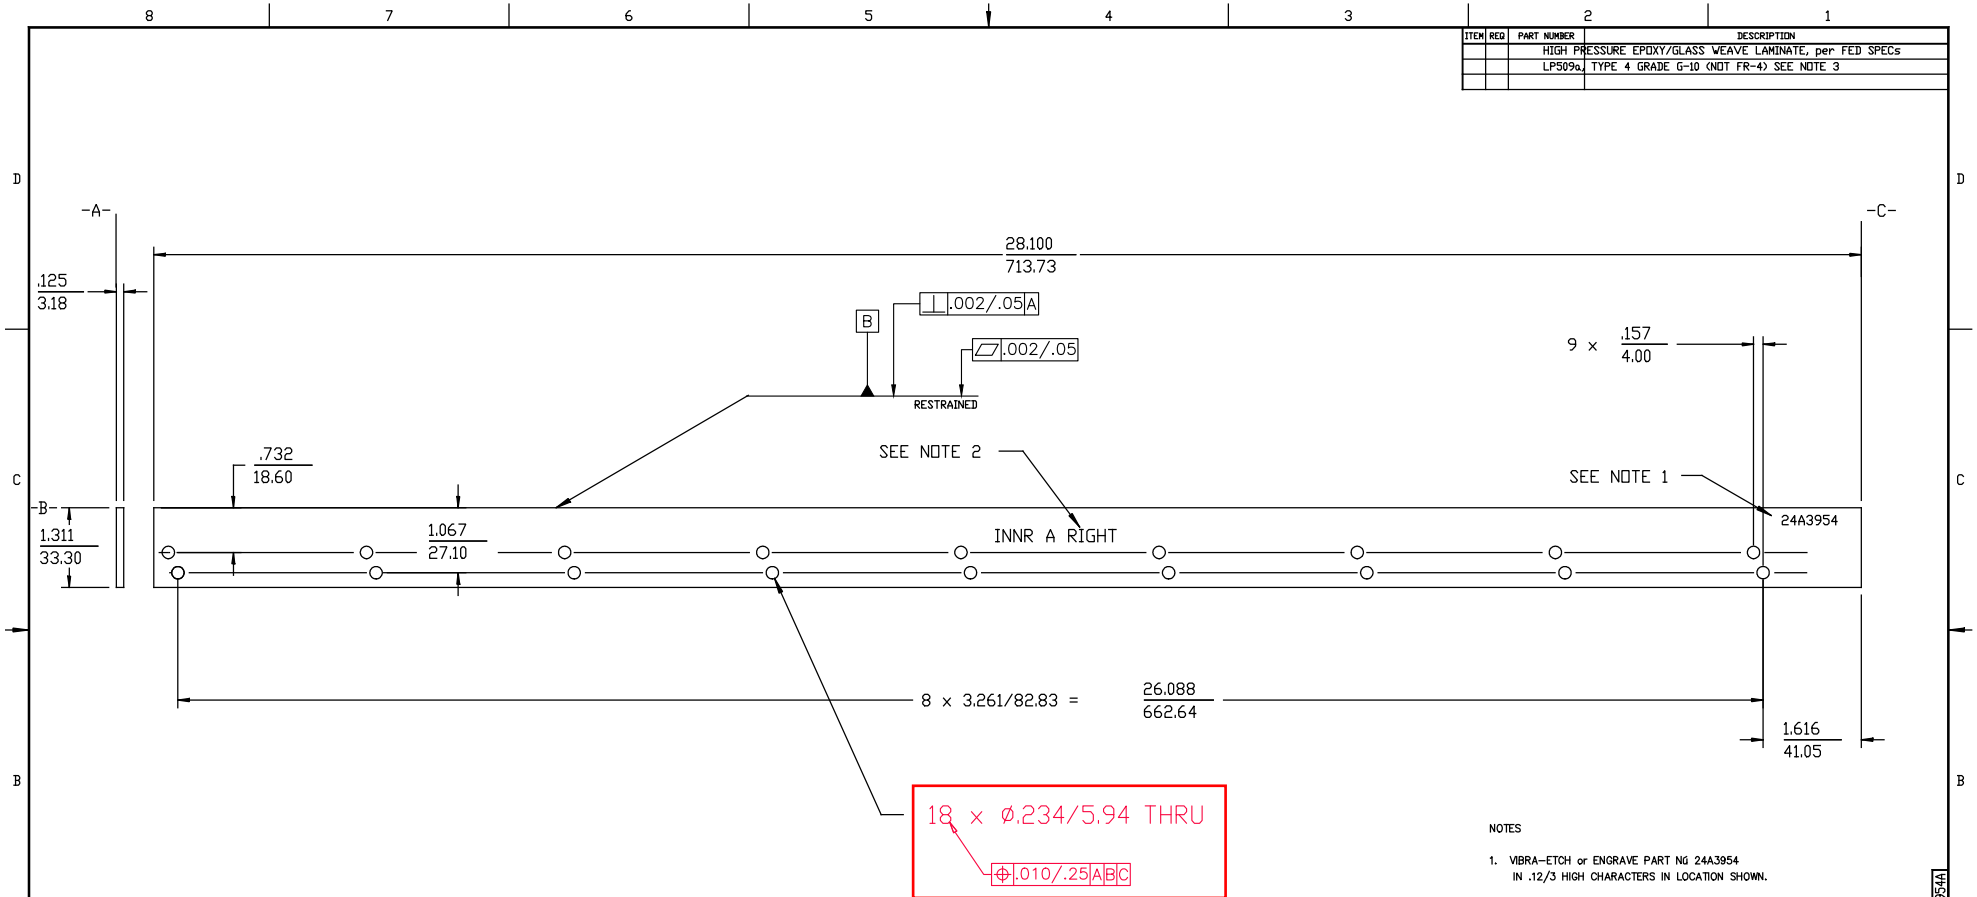

NOTES

1. VIBRA-ETCH or ENGRAVE PART NO 24A3954 IN .12/3 HIGH CHARACTERS IN LOCATION SHOWN.
2. VIBRA ETCH or ENGRAVE "INNR A RIGHT" IN .2/5 CHARACTERS IN LOCATION SHOWN.
3. -REF-: MATERIAL TO BE CERTIFIED BROMINE FREE

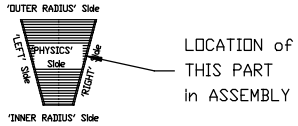

REV.	DWN.	CHK.	ZONE	DATE	CHANGES
A	JB			95/05/11	ADDED STAR DWG #

UNLESS OTHERWISE SPECIFIED
ALL DIMENSIONS ARE INCHES / CENTIMETERS
TOLERANCES: X.X/X = ±.06/.15; .XX/.X = ±0.02/0.05; 0.XXX/.XX=±.004/.01; ANGLES ±.5°; FINISH 125/32
SAWED, FLAMECUT, SHEARED OR STOCK FINISH
ALL SCREW THREADS ARE ISO METRIC CLASS 6
BREAK EDGES .005/.05 MAX ON MACHINE WORK.
REFERENCE - ANSI Y14.5 & IMAL.

SHOP ORDERS
ACCT. NO.
SCH. NO.
DATE REQ'D.
DATE REQ'D.
NO. REQ'D.
DELIVER TO
SURFACE TREATMENT: RINSE IN ALCOHOL
IDENTIFICATION METHOD: SEE NOTES
DRAWN BY: J. BOEHM DATE: 94/01/11
CHECK BY
DATE

Production Approval: Engineering Engineer: J. BERCOWITZ

STAR DRAWING NUMBER: TPC352-D-1 REV. A
RHIC DRAWING NUMBER: XXXXXXXXXX REV. -

LAWRENCE BERKELEY LABORATORY
UNIVERSITY OF CALIFORNIA - BERKELEY

RHIC-STAR-TPC
INNER SECTOR
ANODE WIRE MOUNT, RIGHT

PATENT CLEAR
DRAWING TYPE: DETAIL
SHOWN IN: 00X0000
SCALE: FULL
DO NOT SCALE PRINTS
MICROFILMED
BUDGET ACCOUNT: 8052-24
CATEGORY CODE: SR-02-04
L.B.L. DRAWING NUMBER: 24A3954
REV. A

24A3954A