| ITEM | REQ | PART NUMBER | DESCRIPTION |
|---|---|---|---|
| | | | MADE FROM 24A4541-P1, E-FAB CIRCUIT BOARD |

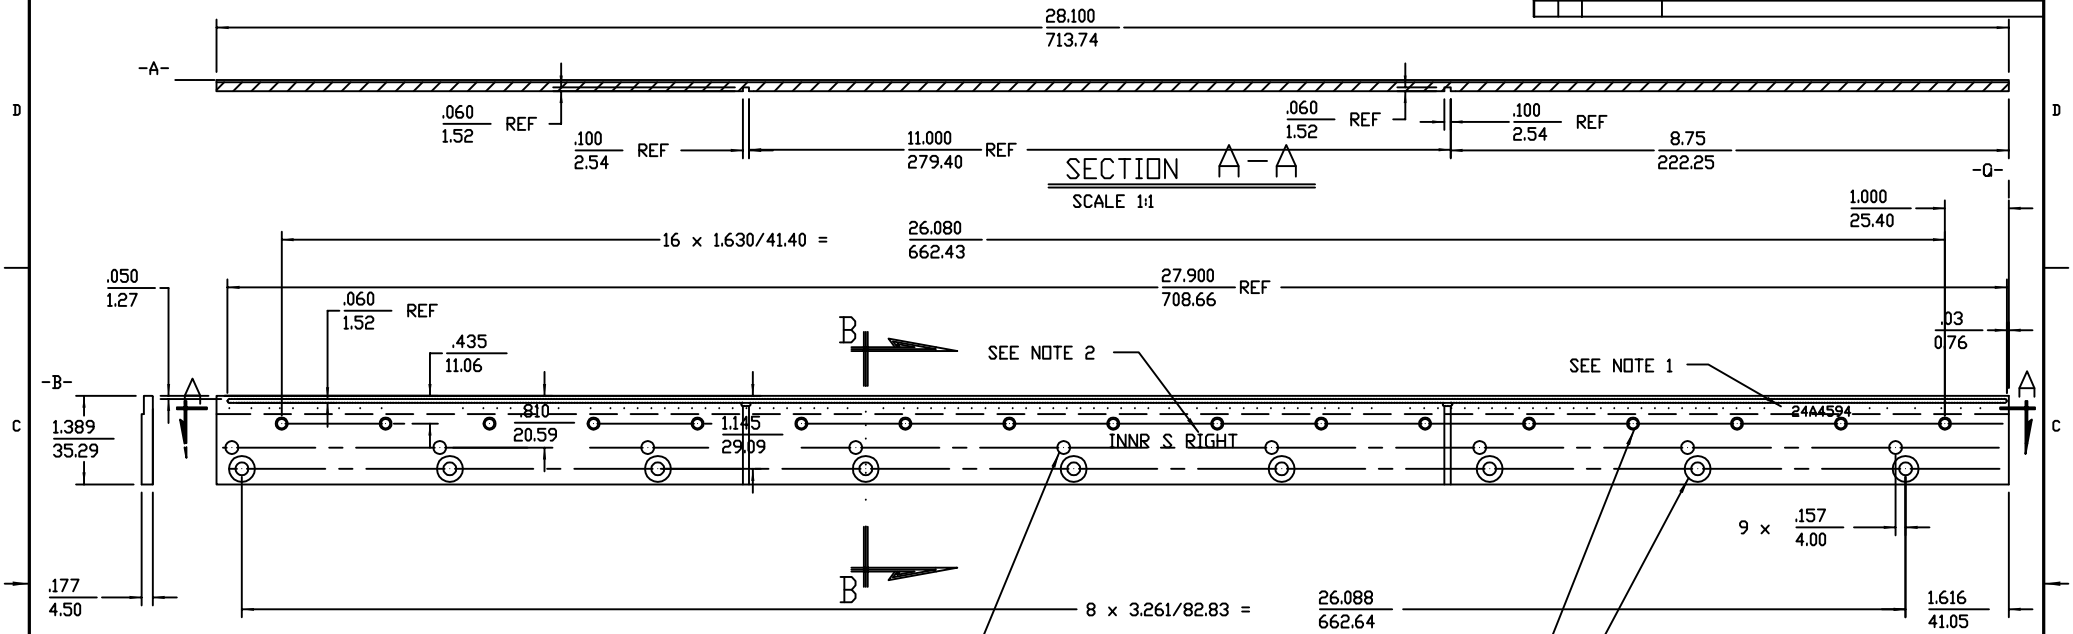


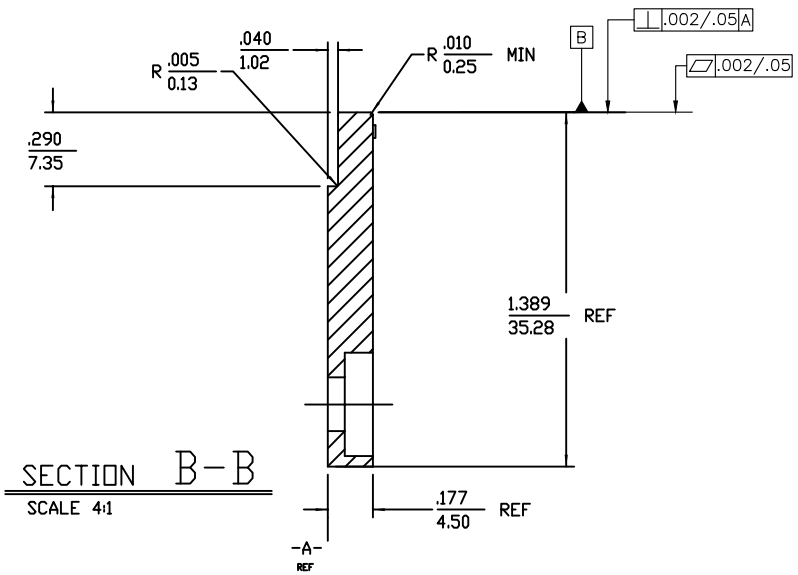


SECTION B-B
SCALE 4:1

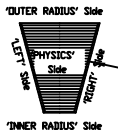


LOCATION of
THIS PART
in ASSEMBLY

NOTES

24A4594A

1. VIBRA-ETCH or ENGRAVE PART NO 24A4594 IN .12/3 HIGH CHARACTERS IN LOCATION SHOWN.
2. VIBRA ETCH or ENGRAVE "INNR S RIGHT" IN .2/5 CHARACTERS IN LOCATION SHOWN.
3. -REF-: MATERIAL TO BE CERTIFIED BROMINE FREE

| REV. | DWN. | CHK. | ZONE | DATE | CHANGES |
|---|---|---|---|---|---|
| A | JB | | | 95/05/11 | ADDED STAR # |

UNLESS OTHERWISE SPECIFIED
ALL DIMENSIONS ARE INCHES / CENTIMETERS
X/X = ±.06/.15 ANGLES ±.5°
.XX/.X = ±0.02/0.05 FINISH
0.XXX/.XX=±.004/.01 125/32
BEVELED, FLANGED, ENGRAVED OR STOCK FINISH
ALL SCREW THREADS ARE ISO METRIC CLASS 6
BREAK EDGES .005/.01 MAX ON MACHINE WORK
REFERENCE - ANSI Y14.5 & 2453.

SHOP ORDERS
RINSE IN ALCOHOL
SEE NOTES
J. BOEHM
95/03/01

Production Approval: J. BERCOWITZ

| STAR DRAWING NUMBER | REV. | RHIC DRAWING NUMBER | REV. |
|---|---|---|---|
| TPC369-D-1 | A | XXXXXXXXXX | - |

LAWRENCE BERKELEY LABORATORY
UNIVERSITY OF CALIFORNIA - BERKELEY
RHIC-STAR-TPC
INNER SECTOR
SHIELD WIRE MOUNT, RIGHT, G-10

| PATENT CLEAR | DRAWING TYPE | SHOWN IN | DO NOT SCALE PRINTS |
|---|---|---|---|
| | DETAIL | 00X0000 | SCALE: FULL |
| RECONFIGURED | DESIGN ACCOUNT | CATEGORY CODE | LBL DRAWING NUMBER / REV. |
| | 8052-24 | SR-02-04 | 24A4594 A |